SEC. 8 TWP. ____ RGE. ____

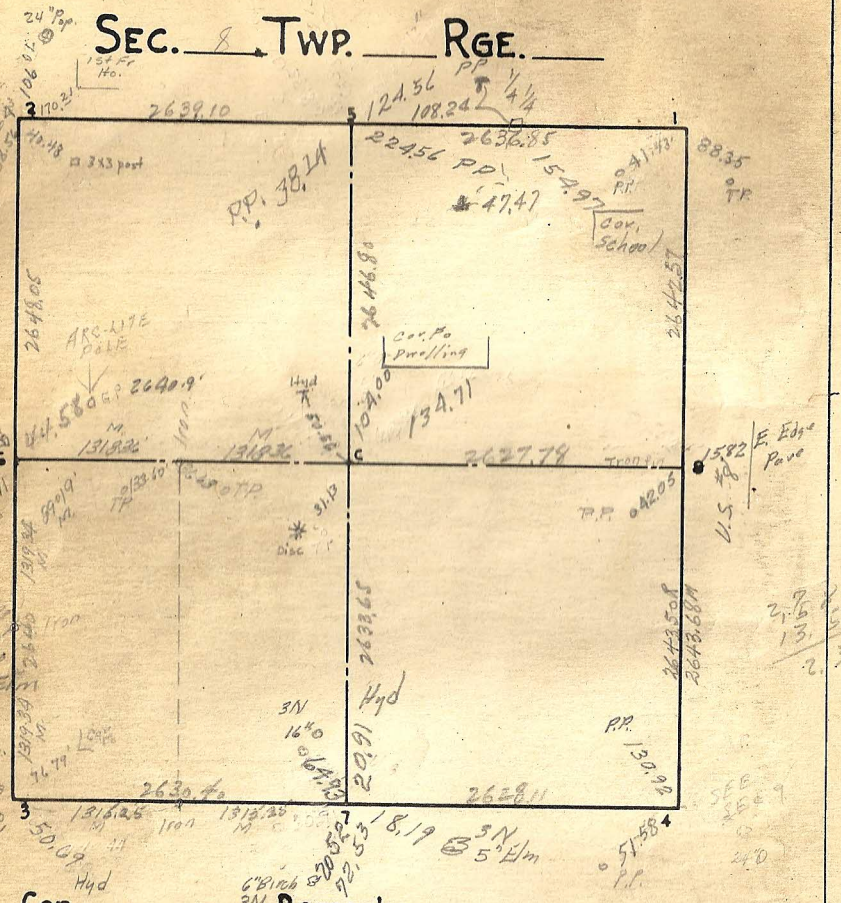

Cor:	Remarks

Mont 1 OK 11/43 3/52

2 89°25' 1/4 3/52 4/65

P.K. Nail 3 OK 10/43 Angle = 90°34' 3/53 12/66

4 OK 11/43 1/46 2/54

5 OK 11/43 3/52 2/54 24.65 pipe

6 OK 11/43 1/4 3/52 2/54 Cor Apt E/65

7 OK 11/43 2/54 10/64

iron pin 8 OK 11/43 1/4 2/54

C.I. mon C OK 11/43 1/4 3/52 1/74