Checked

SEC. 9 TWP. 30 RGE. 23

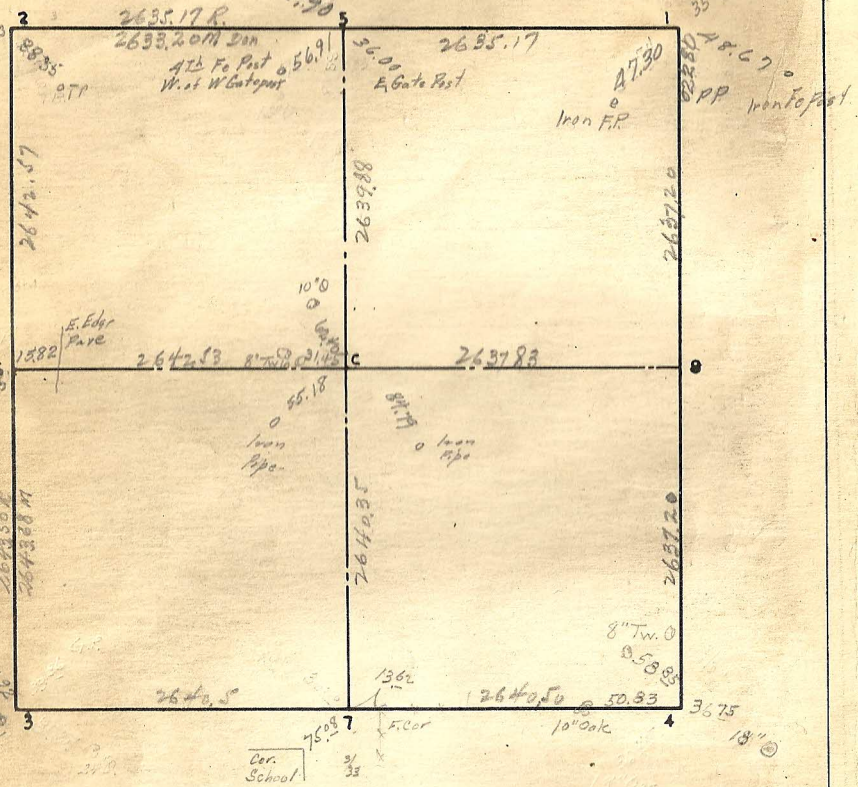

Cor.	Remarks

Mont 1 2/54

2 OK 11/43 3/52

Mont. 3 OK 11/43 2/54

4

Mont 5 2/52

6 OK 11/43 2/54

7

8

C