Checked

SEC. 10 TWP. ____ RGE. ____

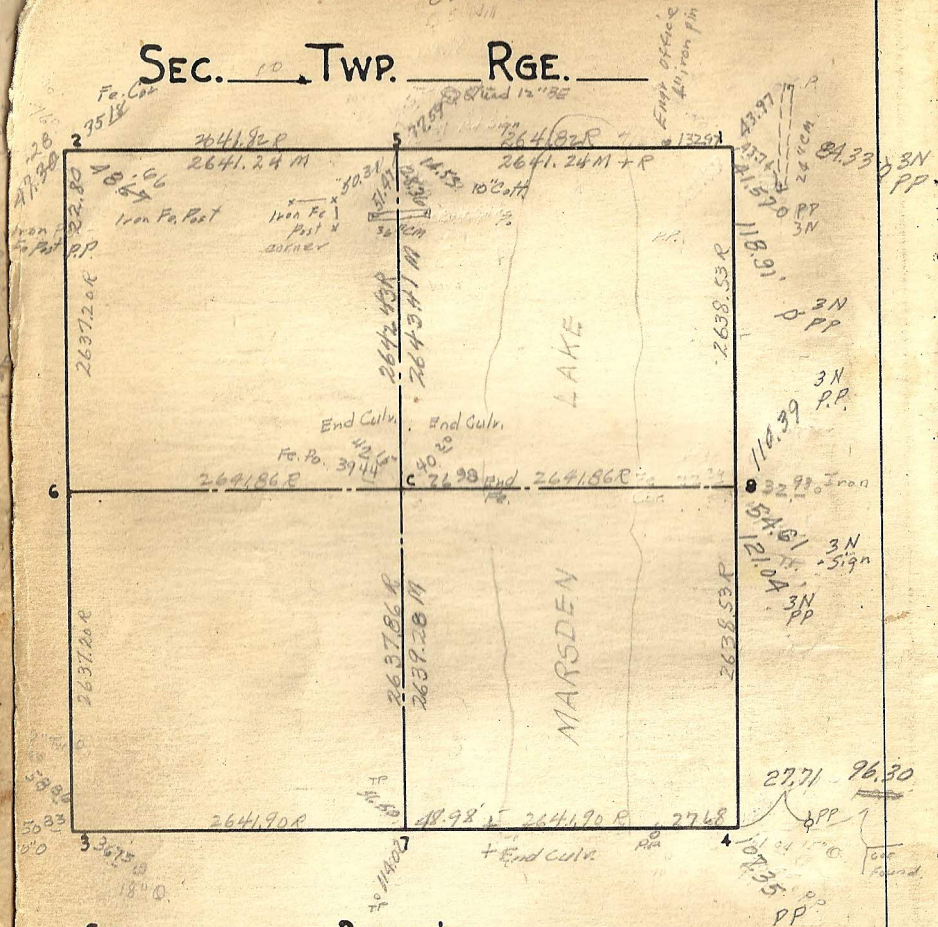

Cor.	Remarks
5	Re-Est. 4-11-32 Dom.

Granite 1 OK 2/54 3/68

2 2/54

3

Granite 4 OK 2/54 10/64 OK 3/68

5 2/54 Retied 4/61 R76 ✓

6

7

Mon over Culvert 8 OK 2/64 10/64

C