SEC. 11 TWP. ____ RGE. ____

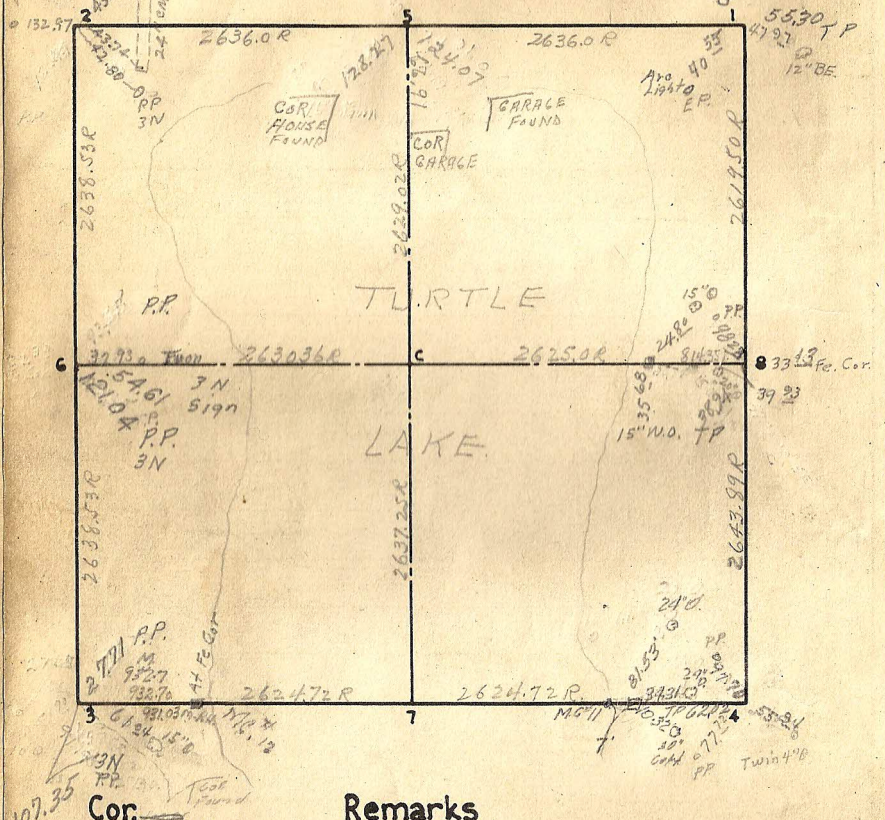

Cor. 96.30

Remarks

4 Reset-10-6-33

M.C. 11 Out 7-10-46 old ties o.k. Set 7' east on high ground 7-10-46 and retied. K.A.

1 OK 12/43 2/54

Granite 2 OK 12/43 OK 2/54 Retied 4/61 RFG 3/68

Granite 3 OK 11/43 2/54 3/68

4 OK 12/43 2/54

5 OK 12/43 3/52

Mont over Culvert (Culv Abandon) 6 OK 11/43 2/54 10/64

7 Intake

8 OK 12/43 2/54

C Intake

M.C. N " S.E. 1/4 Rest 8" Ash

M.C. 12 - Reset 5-27-48

30" O. 15.18 56.51 16" Tw. Willow 8.46' 28.85 19.80 18" O. 18" O.