


SEC. 12 TWP. RGE.

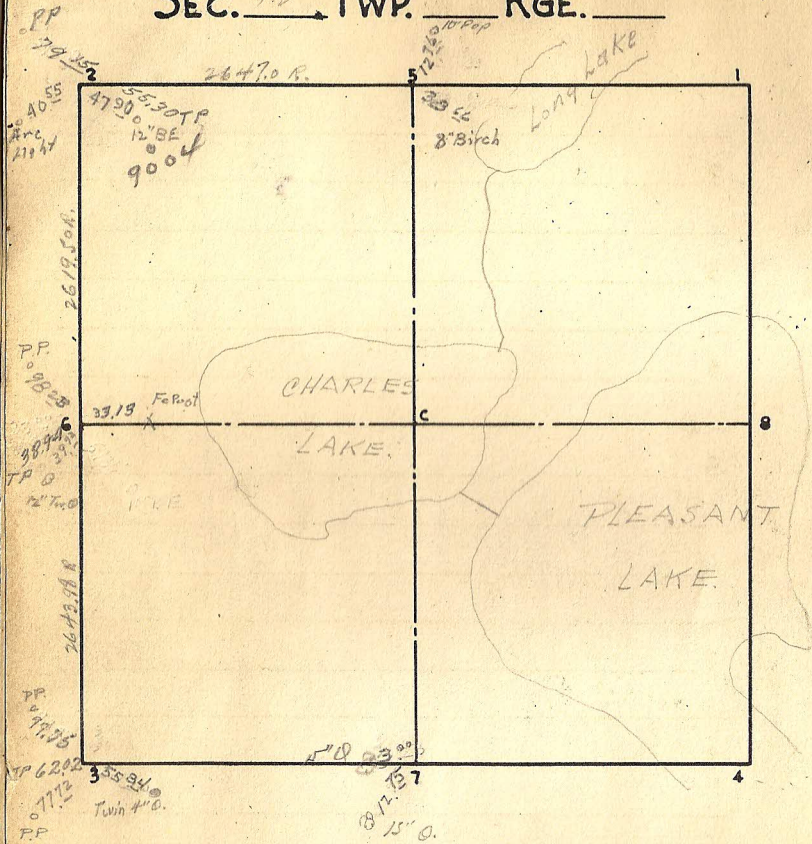

Cor:

Remarks

3 Reset - 10-6-33

- 1 _____
- 2 OK 12/43 2/54
- 3 OK 12/43 2/54
- 4 _____
- 5 _____
- 6 OK 12/43 2/54
- 7 _____
- 8 _____
- C _____
- _____
- _____
- _____
- _____
- _____
- _____