
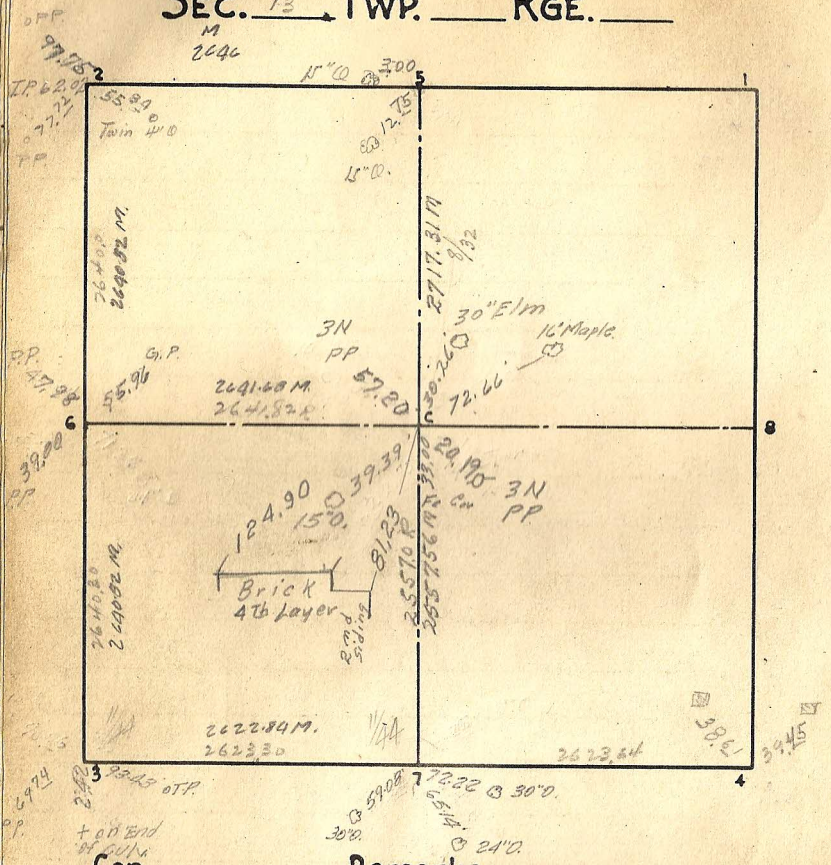

Cor.	Remarks
2	Reset - 10-6-33
6	Re. set 10-5-33

1		
2	OK 12/43 Down 0.4 2/54	
3	OK 12/43	
4	OK 12/43 4/5-r	
5		
6	OK 12/43 2/54	
7	OK 12/43	
8		
C	OK 12/43 2/54 1/64 - 1/74	Iron