SEC. 14 TWP. ____ RGE. ____

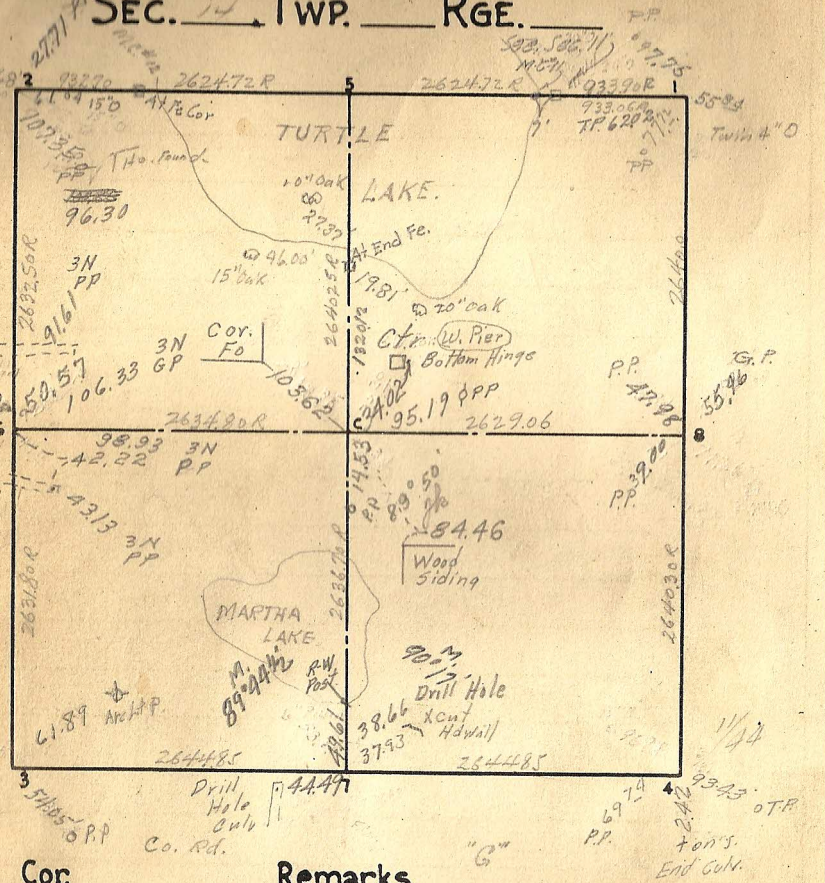

Cor.	Remarks
1	Reset - 10-6-33
8	Reset - 10-5-34

1 2/54

2 OK 11/43 2/54 10/64

3 OK 11/43

4 OK 11/43

Inlak 5

Bolt over Granite 6 OK 11/43 3/52 2/54 3/68

Granite 7 OK 11/43 3/68

Mont 8 2/54

Granite C OK 12/43 3/52 OK/54 10/64 Mont 1/77

M.C. W Line N.E 1/4 OK 12/43