SEC. 15 TWP. ___ RGE. ___

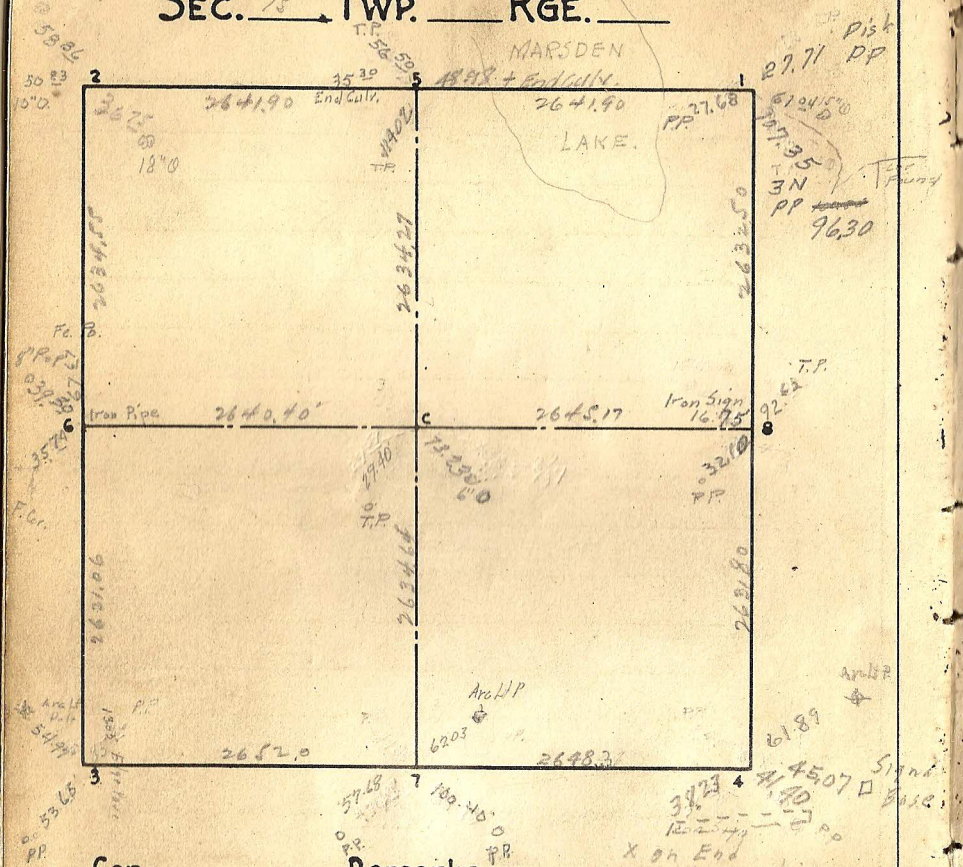

Cor: Remarks

Granite 1 ok 1/4 3/68

2

3 ok 1/4

4 ok 1/4 10/64 JL

5

6

7 Raise ok 1/4

Bolt over Granite 8 ok 1/4 2/54 3/68

C