


SEC. 6 TWP. 14 RGE. 18

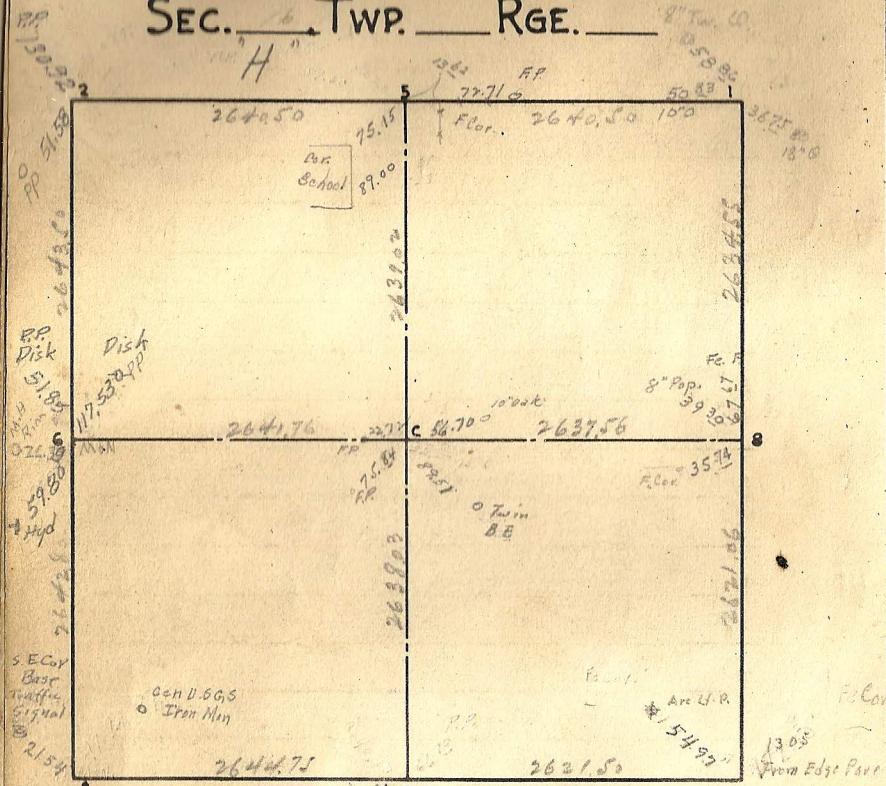

Cor:

Remarks

1 In Ord Plant

Mont 2 2/54

3 ox 1/43

4 In Ord Plant

5 In Ord Plant

6 ox 1/43

7 ox 1/43

8 In Ord Plant

C Ord Plant

Corr Ties to H 147.2, 192.50
199.63
6 P.P.