SEC. 17 TWP. ____ RGE. ____

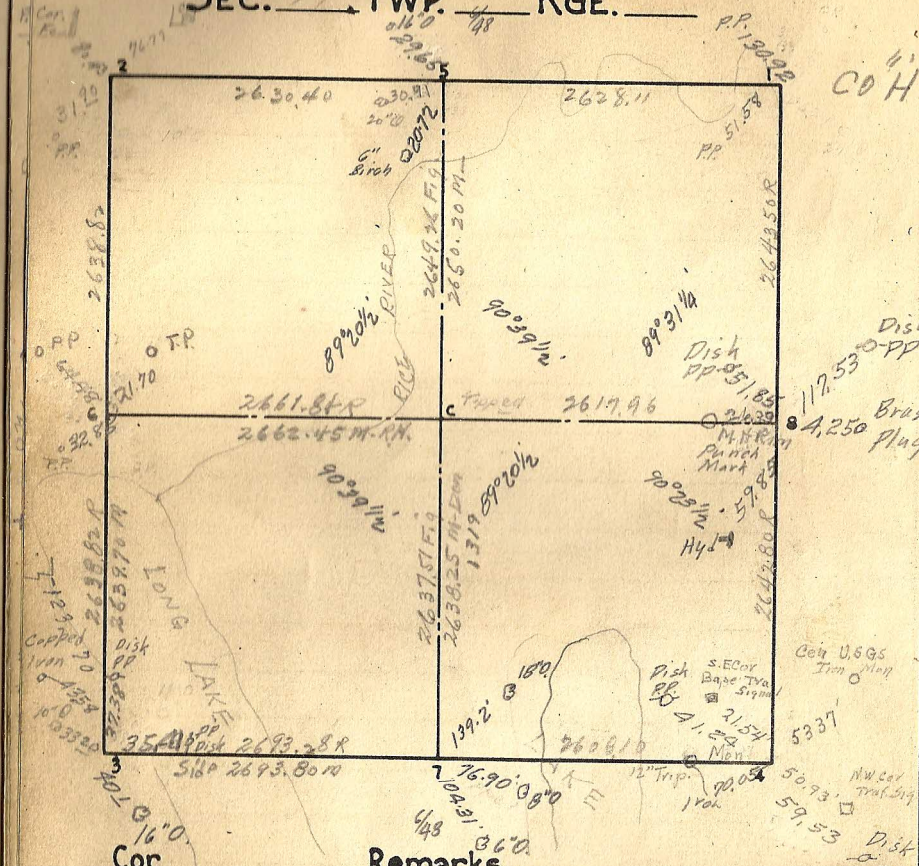

Cor. Remarks

CoRdG

Mont 1 Deeds 131 - 441 OK 11/43 2/54

118 - 228

2 Z. Mic'l. 170 OK 10/43

C. " 212

M.H. 3 OK 11/43 OK 11/48 6/65

Granite 4 OK 11/43 3/68

5 OK 11/43 2/54

6 OK 11/43 2/54

7 Found Mont OK. by K.R. 6-8-48

Granite 8 OK 11/43 9/65

C Reset by Intersection.-

38.68' x 31.13 x 26.46 x

35.33' x 30.25' x 27.53 x