SEC. 18 TWP. ___ RGE. ___

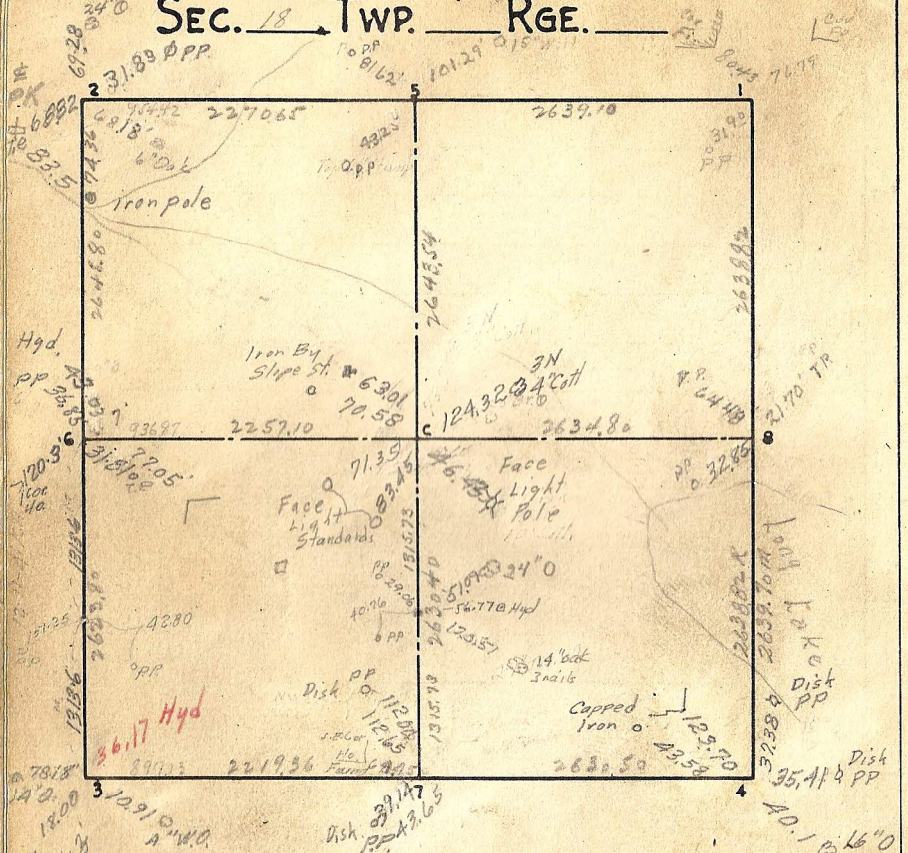

Cor.	Remarks

1	OK 10/43	3/53
2	OK 10/43	OK 12/54 OK 53
3	OK 11/43	2/54 4/54
MH 4	OK 11/43	2/54 6/65
5	OK 10/43	3/53 OK 2/61
6	2/54	
7	2/54	10/65
8	OK 11/43	2/54
C	2/54	11/64