SEC. 20 TWP. ____ RGE. ____

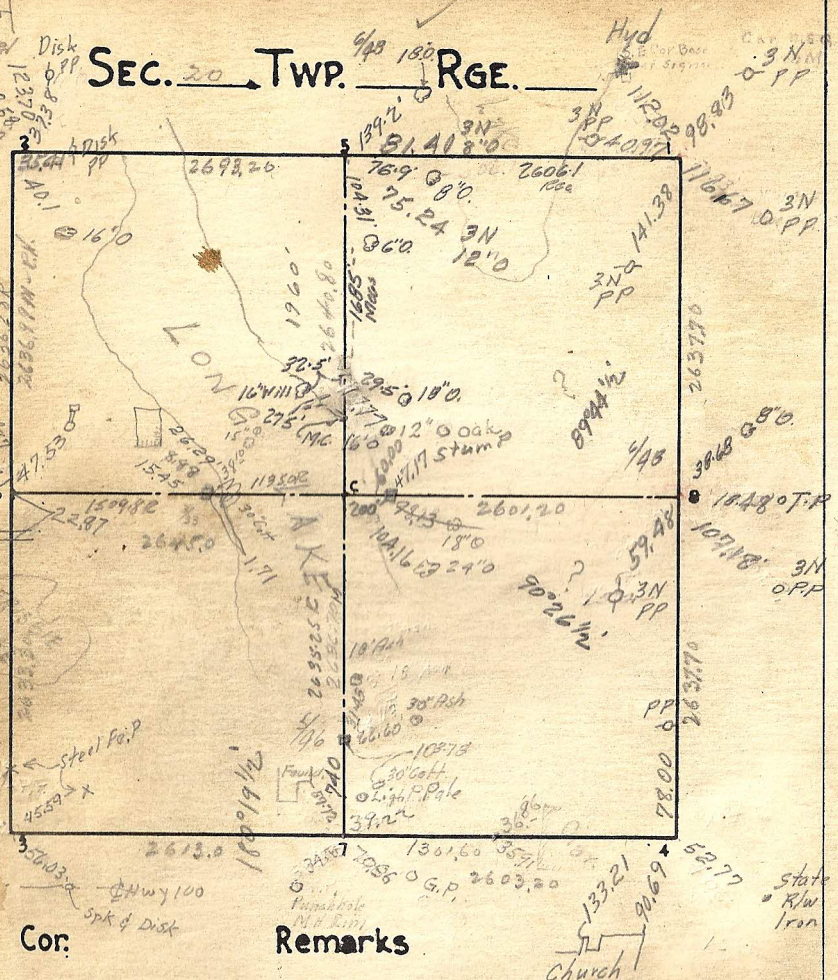

Cor. Remarks

Granite 1 OK 11/43 3/68

MH 2 OK 11/43 6/65

3 OK 11/43 Retied 6-49

4 7/64

Small Granite over Large Granite 5 Found Mont. OK. by K.A. 6-8-49 3/68

C.I. 6 RESET 11/18 2/54

7 OK 11/43

Granite 8 OK 11/43 3/68

C Intake

Granite M.C. OK 11/43 W Line S.E. 1/4 OK 11/43 3/68

Granite M.C. OK 11/43 N Line S.W. 1/4 OK 11/43 3/68

Granite M.C. OK N Line S.E. 1/4 OK 11/43 3/68

Granite M.C. on W Line N.E. 1/4 Reference 3/68