SEC. 21 TWP. ____ RGE. ____

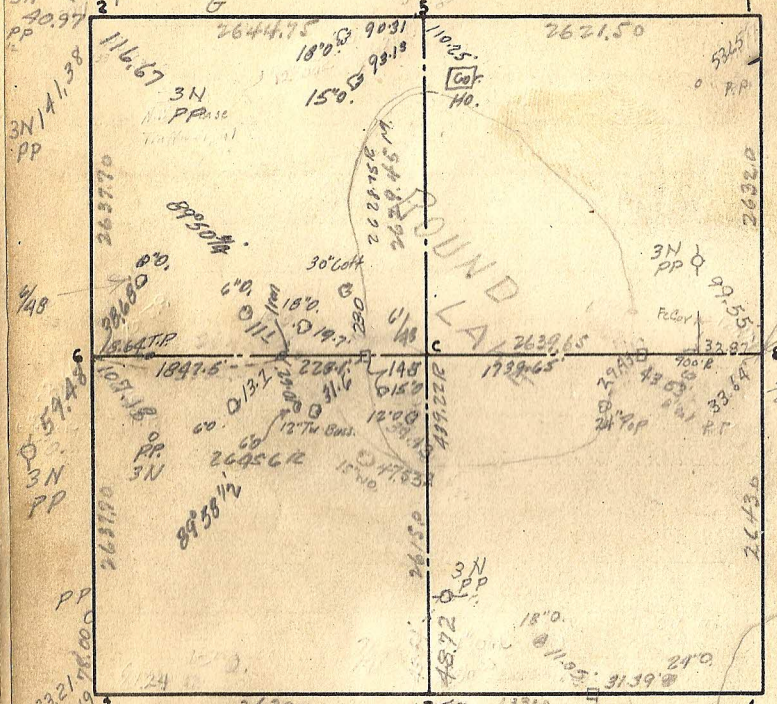

Cor.	Remarks