SEC. 22 TWP. ____ RGE. ____

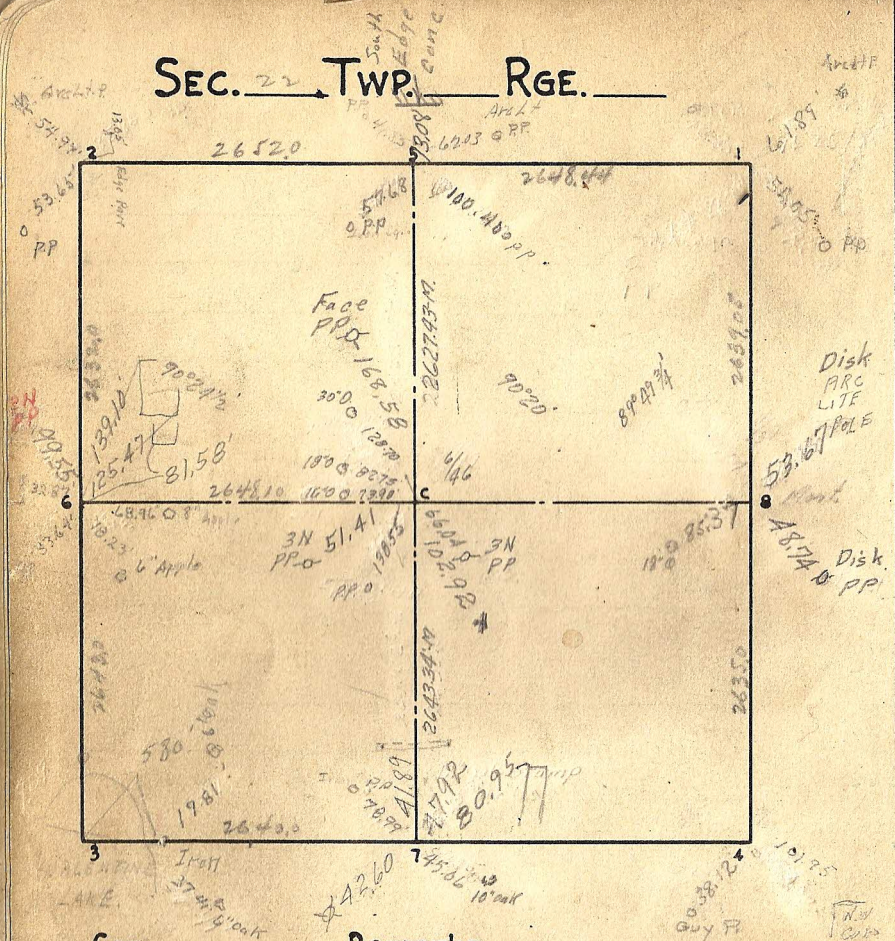

Cor.	Remarks
8	Set iron from old ties 9-32 Don.
	Set iron Witness Cor on South Line 7/16/39

1 OK 11/43 1/46

2 OK 11/43 1/46

3 In Lake

4 OK 11/43

5 OK 11/43 1/46

Granite 6 OK 11/43 1/46 7/70

7 OK 12/43 1/46 55.83

Granite 8 OK 11/43 1/46 8/65

C Est by straight Line between Corners 5-7 and using Tie 87.57 9/19/39 K.F.

Place Mon