SEC. 23 TWP. 30 RGE. 23

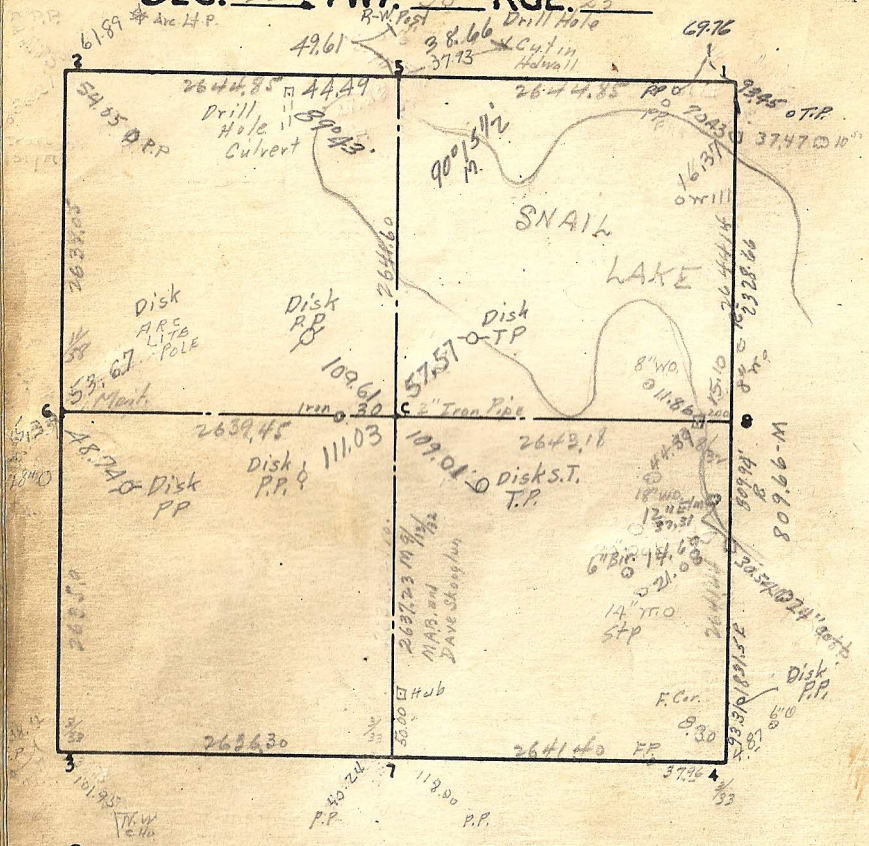

Cor.	Remarks
C	Re-est. 9-13-32
6	Replaced with iron from old line 9/32
2	SE T.P. = 93.43, S.W. P.P. = 69.75, + on 2nd call = 2.42

1 3/48

2 OK 11/43

3 OK 11/43

4 OK 4/43

Granite 5 OK 11/43 3/68

Granite 6 OK 11/43 3/63

7 OK 1/43

8 In Lake

C.I. C OK 17/63

WC OK

MC #10 Reset 2/63

74.18

2" x 2' Hub

M.C. Fresight