



NE 1/4
NW 1/4
SEC. 24

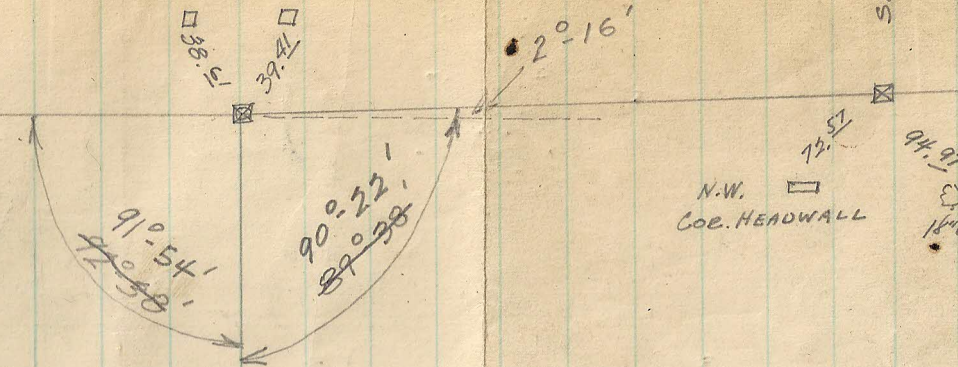


N.W.
COR. HEADWALL

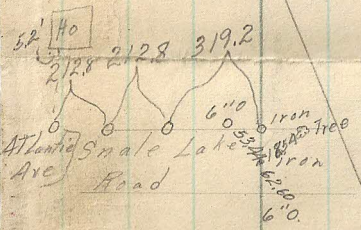

183.77
605.07
725.07
263.12

2632.42

2632.42
2624.25
08.17'

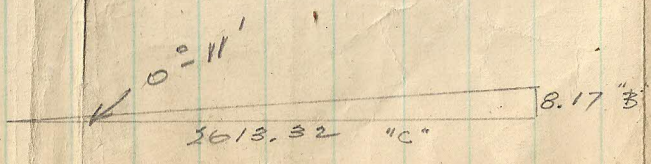

K.P. 211