SEC. 25 TWP. ____ RGE. ____

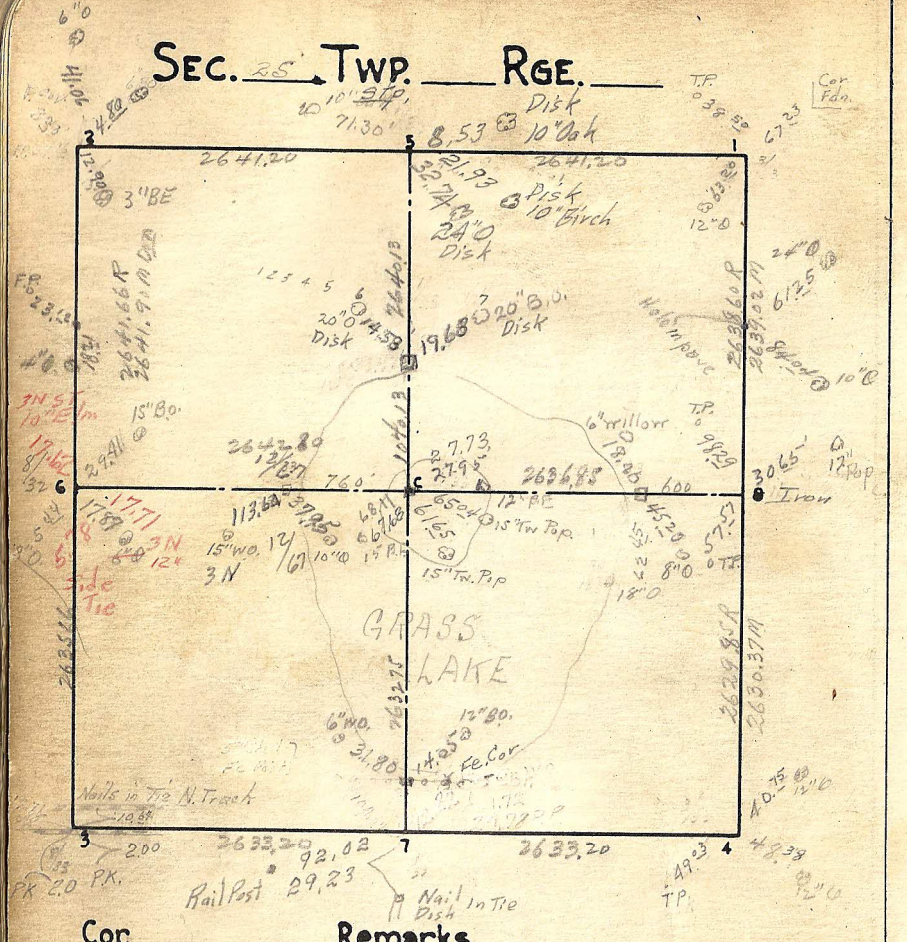


| Cor. | Remarks |
|---|---|
| 8 | Re. Est. nail placed in Pave 1-21-33 Don. |

104.87
91.72

1 OK 12/43

2 OK 12/43

Iron Pin over Granite 3 OK 12/43 10/65

4 OK 12/43

Granite 5 OK 12/43 10/65 Reset 2/6

Granite 6 OK 12/43 4/74

7 OK 12/43 Set Mont. 4-30-49

8 OK 12/43

Granite C OK 12/43 Straightened 12/67

MC W Line SE 1/4 OK 12/43

MC W Line N.E 1/4 OK 12/43

MC N Line SW 1/4 OK 12/43

MC N Line S.E 1/4