SEC. 26 TWP. ___ RGE. ___

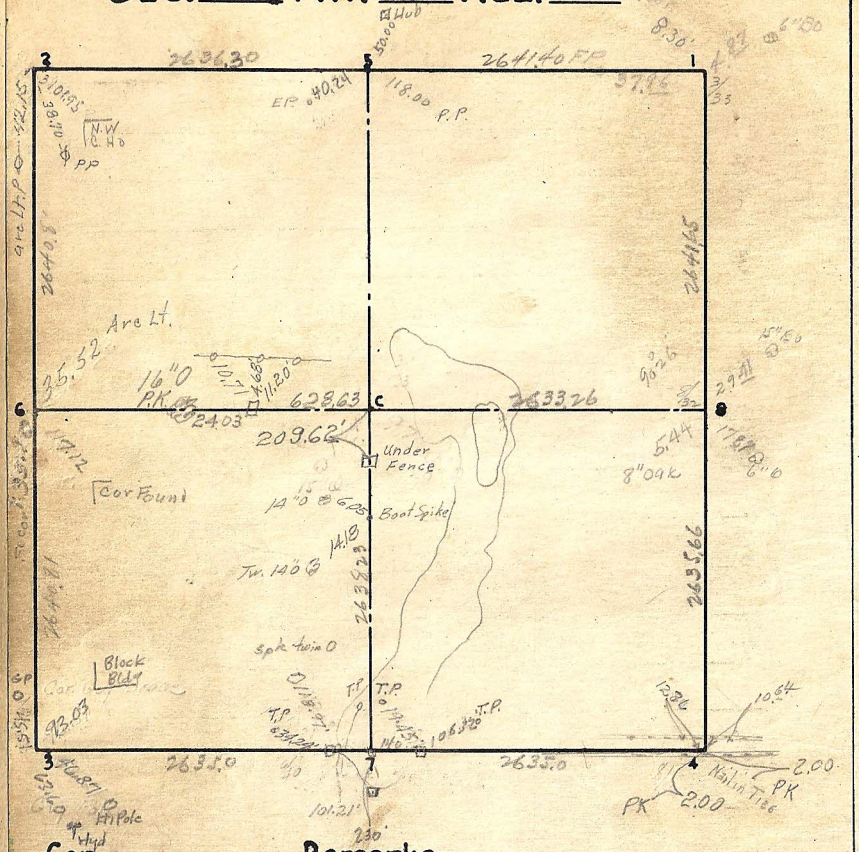

Cor.	Remarks
4	c. Ho Not N Rail on So. Track.

24 40-81
26 35:C.1

1	OK
2	OK
3	OK 1/43 OK 5/70
4	Iron Pin over Granite OK 12/43 1'N of N. Rail S. Track 12/53
5	OK 12/43
6	OK 12/43
7	Est & placed Mon 3/42 OK 12/43 New Ties 5/54 Down 6" Mon
8	OK 12/43
C	OK 12/43 Placed Reference Monuments 9/67

Tie Set 67
Nail in tie
69.51
124.06 TP