SEC. 30 TWP. ___ RGE. ___

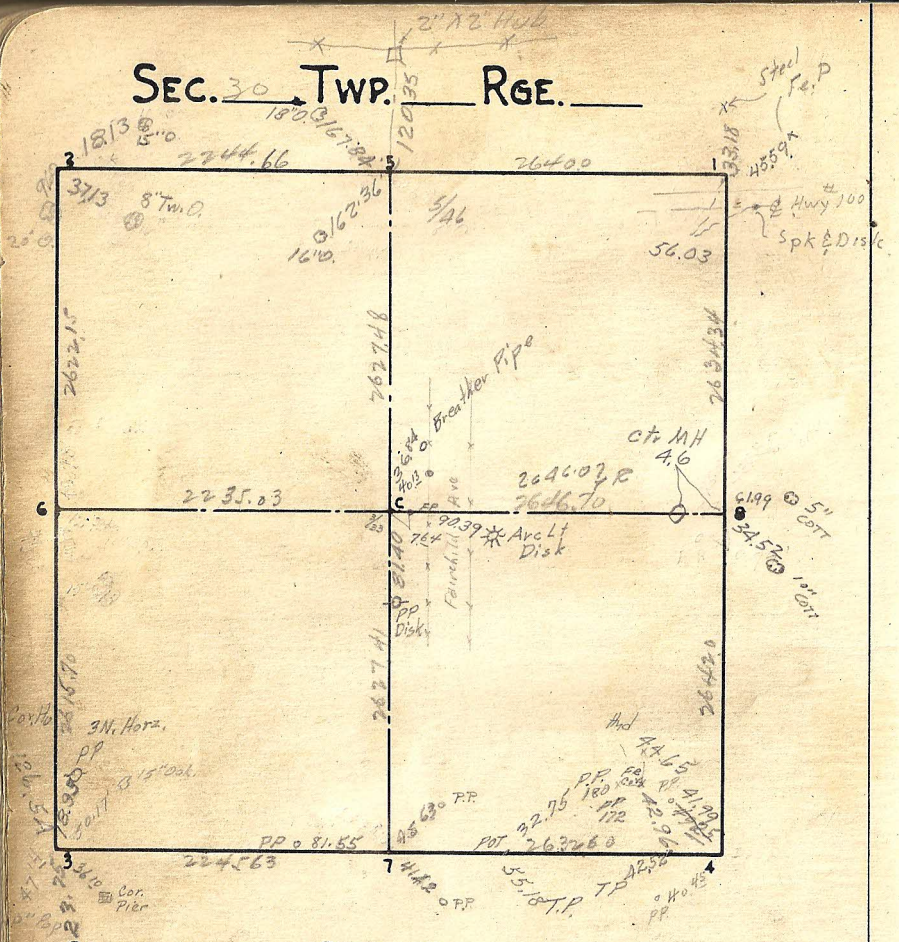

1 OK 12/43 Retied 6-49

2 OK 12/46

Granite 3 OK 11/43 OK 12/46 6/69

~~Mont~~ Iron Pipe 4 10K 12/43 2/54 PP Disk

5 OK 12/43

6 OK 11/43 OK 12/46 PP Disk Arc Lt Disk

Iron 7 OK 11/43 OK 12/46 2/54

8 OK 12/43 Retied 5/24/66 - PK Nail 3/64

C OK 11/43 OK 12/46