


Cor Brick

SEC. 31 TWP. 72 RGE.

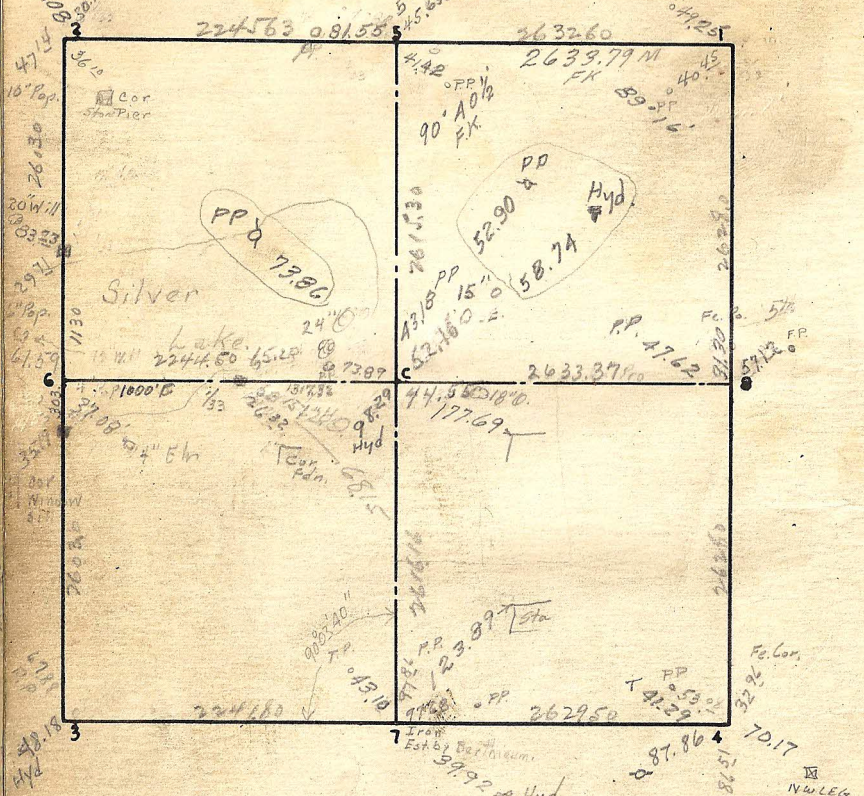

Cor:	Remarks
7	Re-surveyed by Bartholomew 1932

Granite

- 1 OK 1/43 OK 12/42 2/54
- 2 OK 1/43 OK 12/46 6/69
- 3 OK 1/43 OK 12/46
- 4 OK OK 14/46
- 5 OK 1/43 OK 12/46 2/54 3/60
- 6 In Lake see MC
- 7 OK 1/43 3/60
- 8 OK 1/43 2/54 Fe Tipped

C. I. Mon
1975

- C OK 1/43 OK 12/46 2/54 3/60
MC West Line OK 1/43 N 1/4 Tipped South
MC E/W 1/4 OK 1/42 OK 12/46
MC SK