

A. R. "Art" Abbott

Minneapolis, Minn.

Phone Nestor 0841


53 + 50 to 54 + 50

51 + 50 ? 25' Ent

47 + 50 Intersection
Embed on Corners

Hennard. 50d SW cor loc.


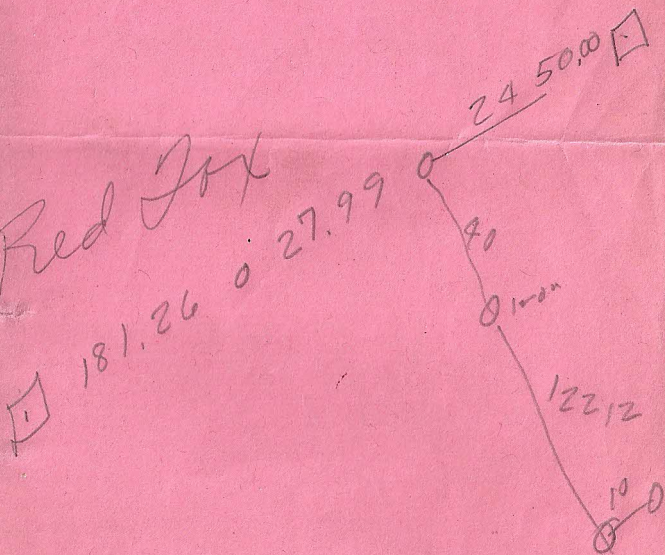

ROSHOLT EQUIPMENT CO.

3188 Snelling Ave. So.
Minneapolis, Minn.

Phones DUpont 8351
NEstor 2113