# SEC. 35 TWP. ___ RGE. ___

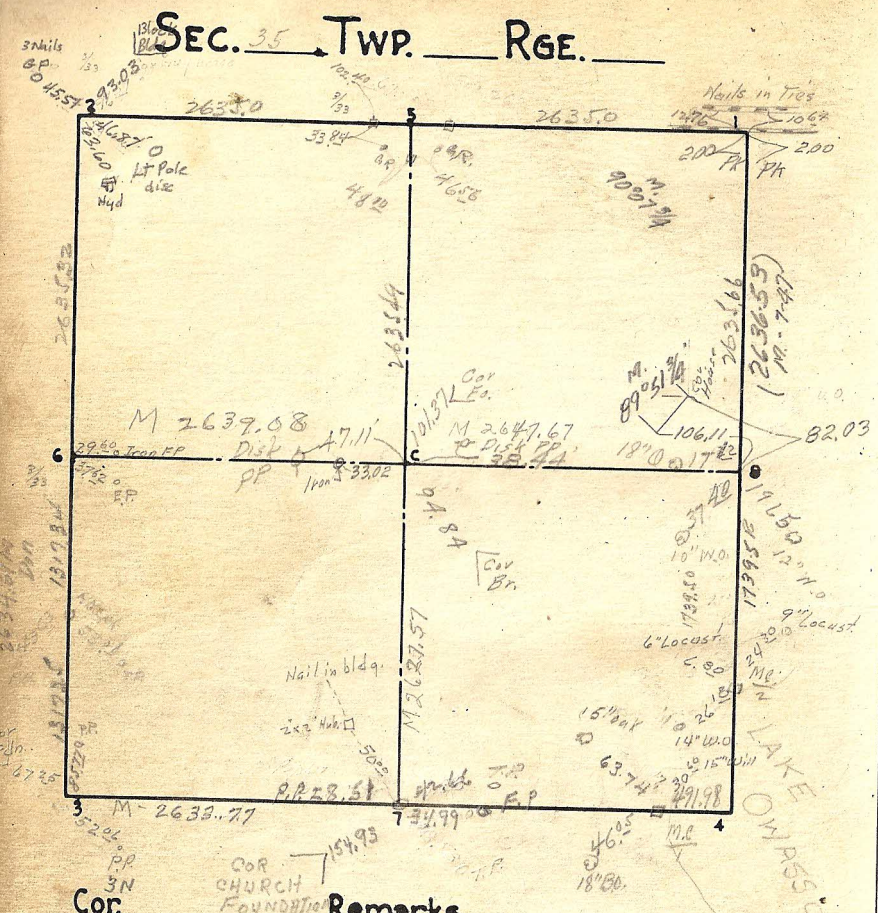


| Cor. | Remarks |
|---|---|
| 7 | Placed Bld. Mont 4/21/37 HB. |
| | From Surveyors Visit St Regarding |

| | | |
|---|---|---|
| Iron Pin over Granite | 1 | OK 11/43 10/65 |
| | 2 | OK 12/43 OK 8/70 |
| | 3 | OK 11/43 |
| | 4 | S. M.C |
| | 5 | OK 12/43 |
| | 6 | OK 11/43 |
| | 7 | N.W = 90°20' NE = 89°39' |
| stone | 8 | OK 12/43 11/54 - 5/64 |
| C. Iron mon ~~Stone~~ | C | OK 12/43 Replace Mont 5/64 |

Nail in tree o T.P

69.83 124.15 o T.P

Tie For #5

M.C #2 OK 12/43

M.C #1 OK 12/43