SEC. 36 TWP. 30 RGE. 2

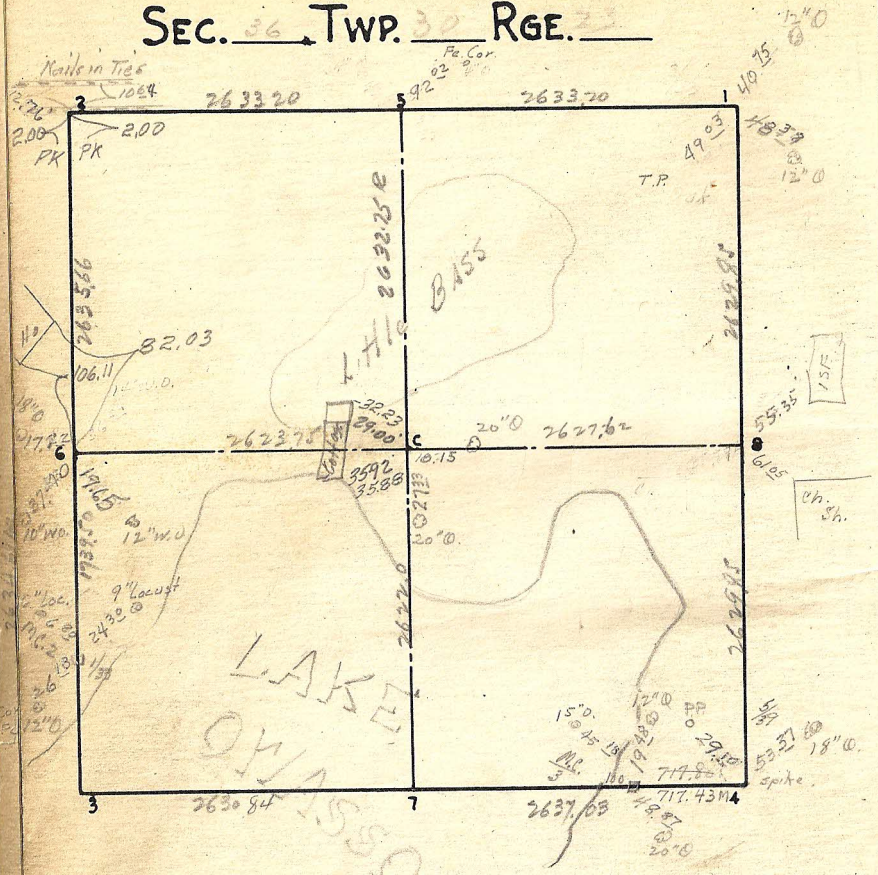

Cor.	Remarks

1 OK 12/43

Iron Pin Over Granite 2 OK 12/43 10/65

3 In Lake

4 89°23'

5 OK 12/43

Stone 6 OK 12/43 11/54 - 5/64

7 In Lake S.E.M.C

8 OK 12/43

Stone C OK 12/43 New ties after Ho Remodeled 5/64

M.C. OK.
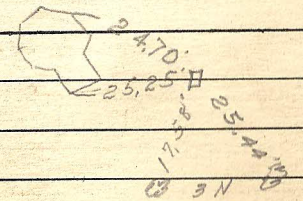
Stone Mc #3