


SEC. 4 TWP.          RGE.         

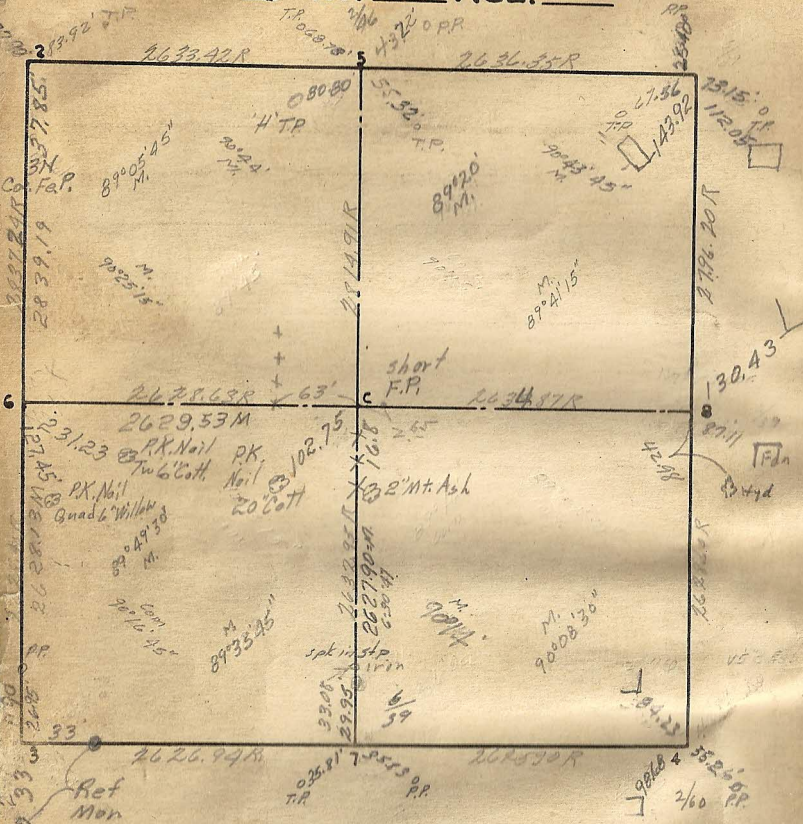

Cor.

Remarks

C OK notes (placed best spl in C)

Granite 1 OK 1/66

2

3 Found Mound 6-5-10 K.A.

4

5

C.I. Mon. 6 3/18/67

Mant 7 4/60 Sec. 11

Iron pipe 8 4/63 iron 1/66

C