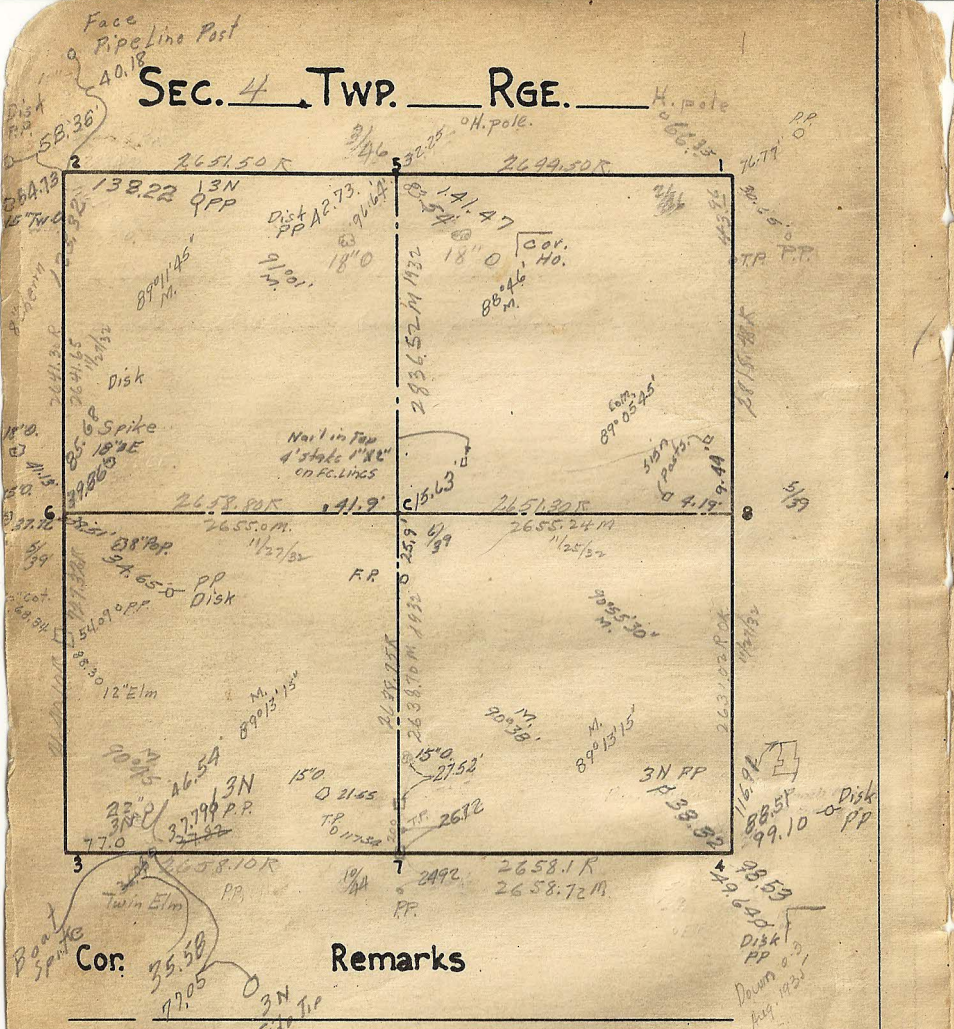

1 MH

O 54.3

2 New tie 10/63 Reset 11/63

O 30.3

MH

3

Granite 4 Should be reset 5/67

5 7/64 dk

Iron 6

Iron 7 Tipped 4/67

8

C