SEC. 6 TWP. 29 RGE. 22

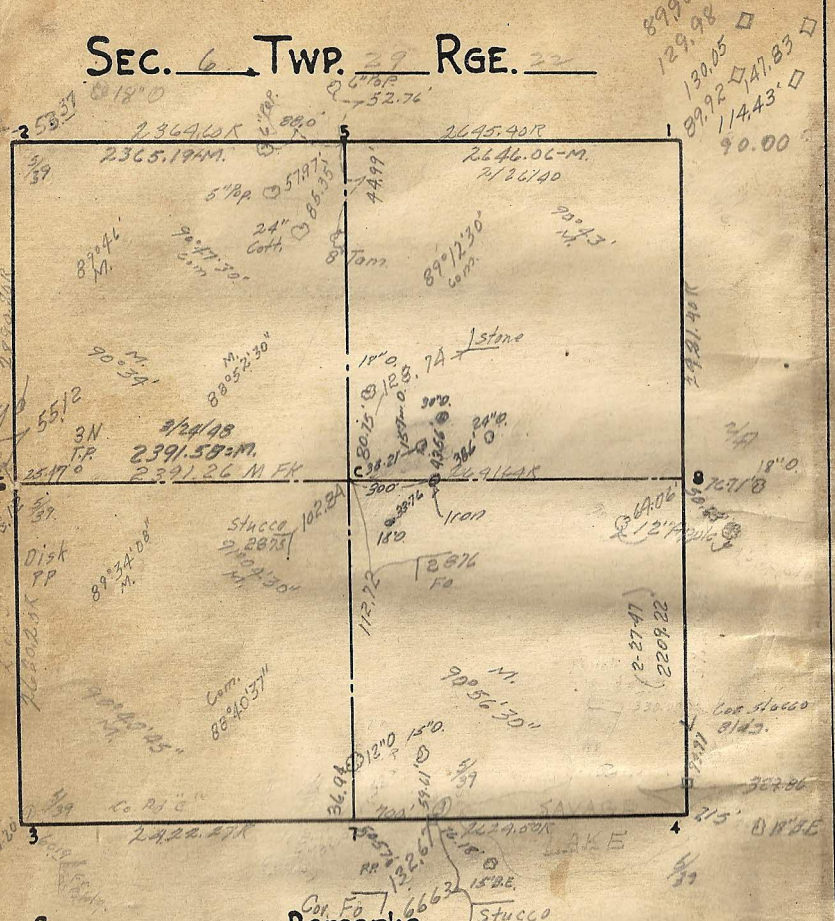

Cor.

Remarks

Granite 1 OK 3/60 11/67 5/72

2

3

4

Iron 5 Placed iron - 2-26-40 - K.A. 1/65

Iron over Granite 6 4/67

7

8 Tipped set 66"
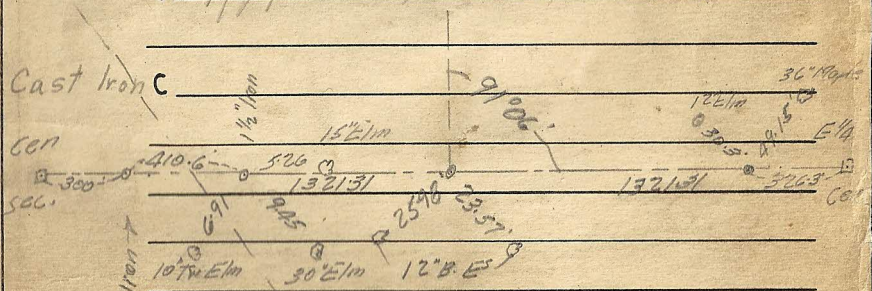
Cast Iron C