SEC. 11 TWP. ___ RGE. ___

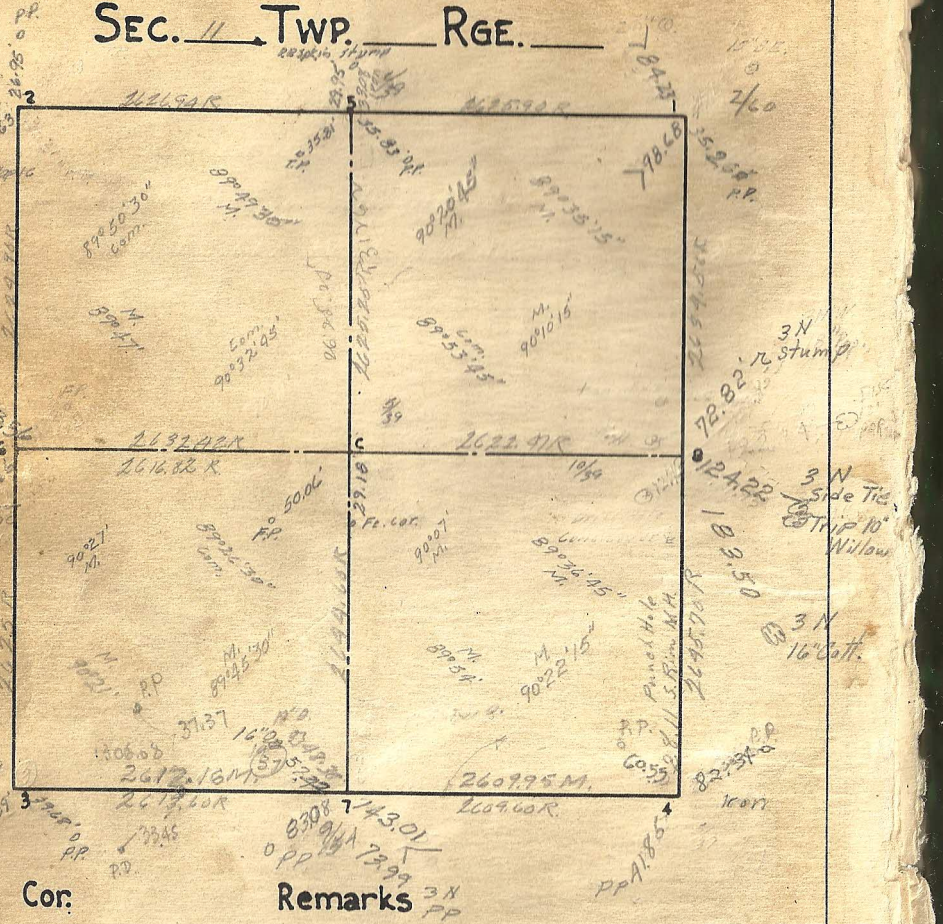

1 _____

2 Found Mont. 6-5-40 K.P.

3 Tipped

C.I. 4 4/68

Mont 5 4/60

Retired 6/5/61 Reset

6 _____

Mont 7 10/54 4/68

C.I. 8 New Ties 3/15/61 RFG Reset in New Location as per N.S.P. 4th Add 11/30/67

C _____