



SEC. 16 TWP. RGE.

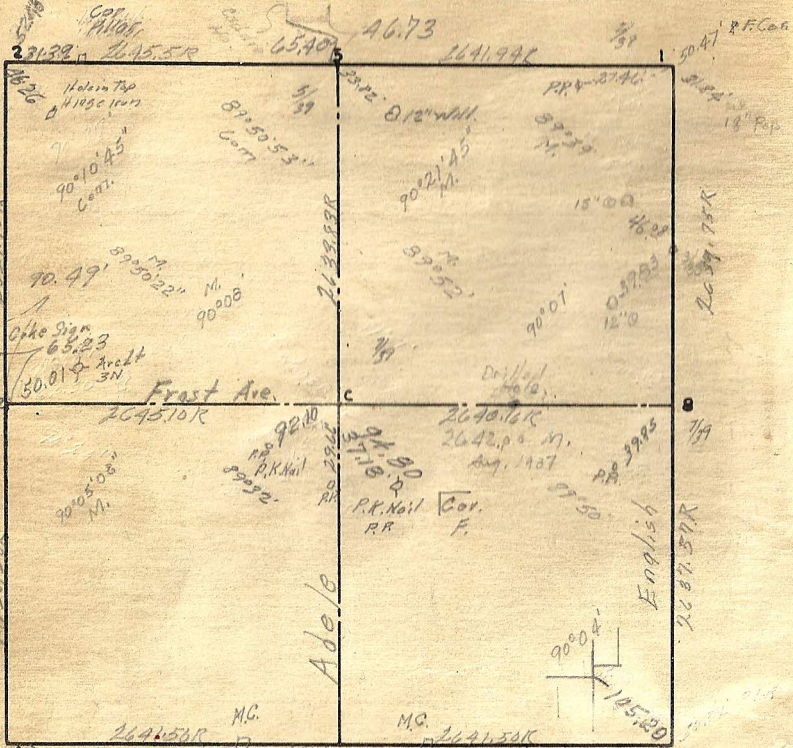

Cor. Remarks

8 Found iron & wooden box and placed brass plug 11-31-27

Granite 4 2/107

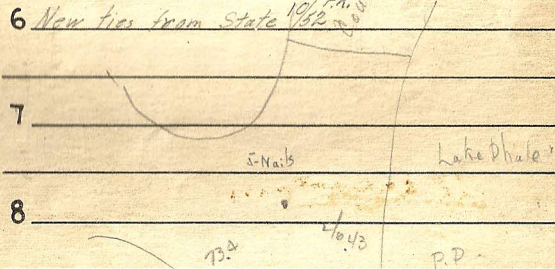

Steel plate C 6/107