


SEC. 17 TWP. RGE.

1/8

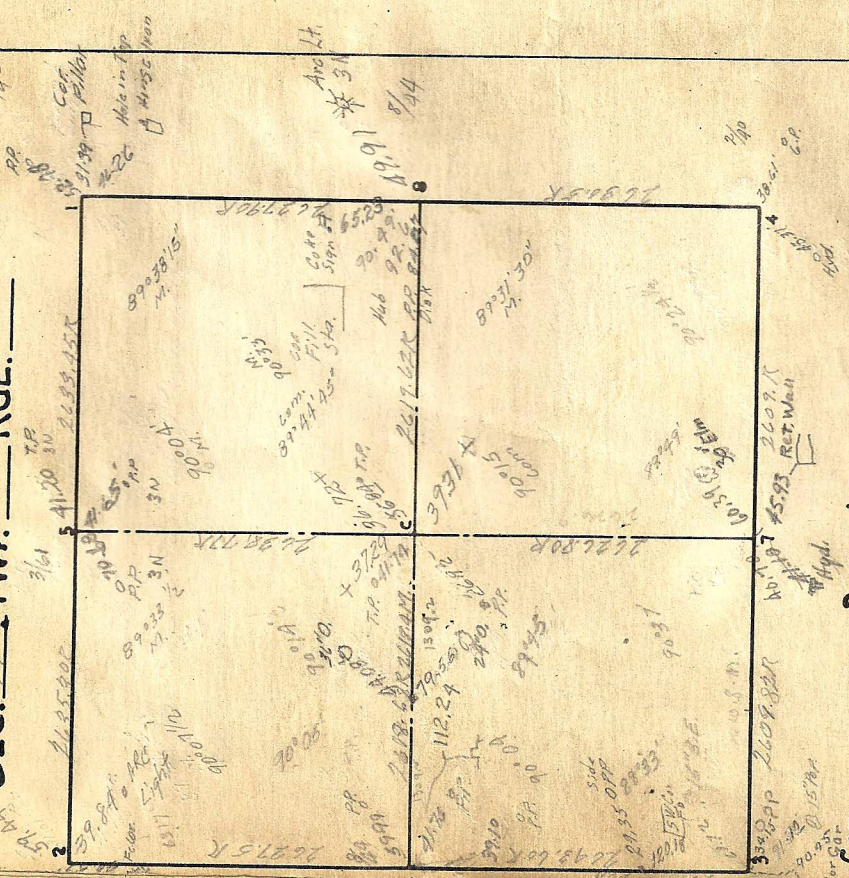

Remarks

Cor.

1

2 Retied 3-13-61

3

4

5 Retied 3-13-61

6

7

8 1-31-39 Found Nails Under Concrete and Wood
Nails

Brass Plug - N.B. New Ties for State 10/22/41

C Brass Plug New Tie 10/25 Cover of Signal Base