


Sheet No. 108

SEC. 19 TWP. RGE.

Rice St

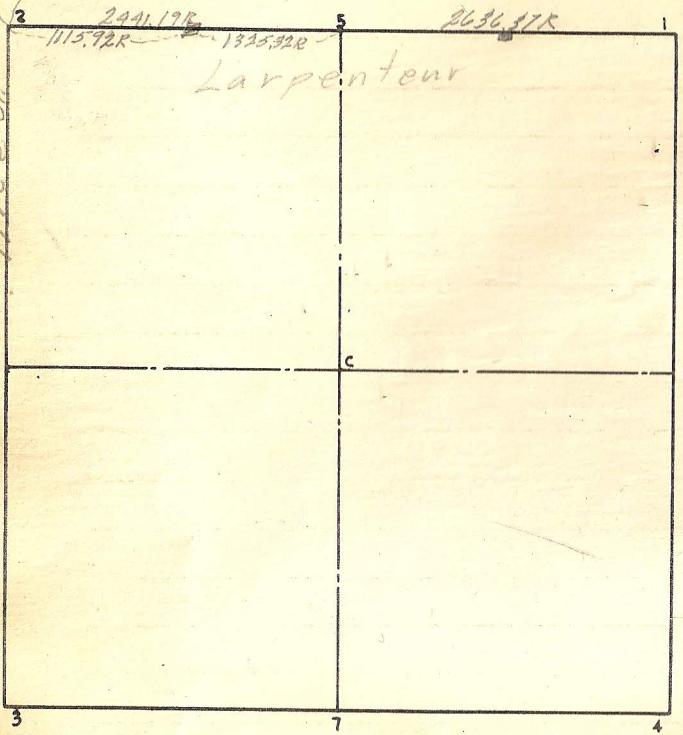

Cor: Remarks

1 _____

2 _____

3 _____

4 _____

5 _____

6 _____

7 _____

8 _____

C _____
