


SEC. 23 TWP. RGE.

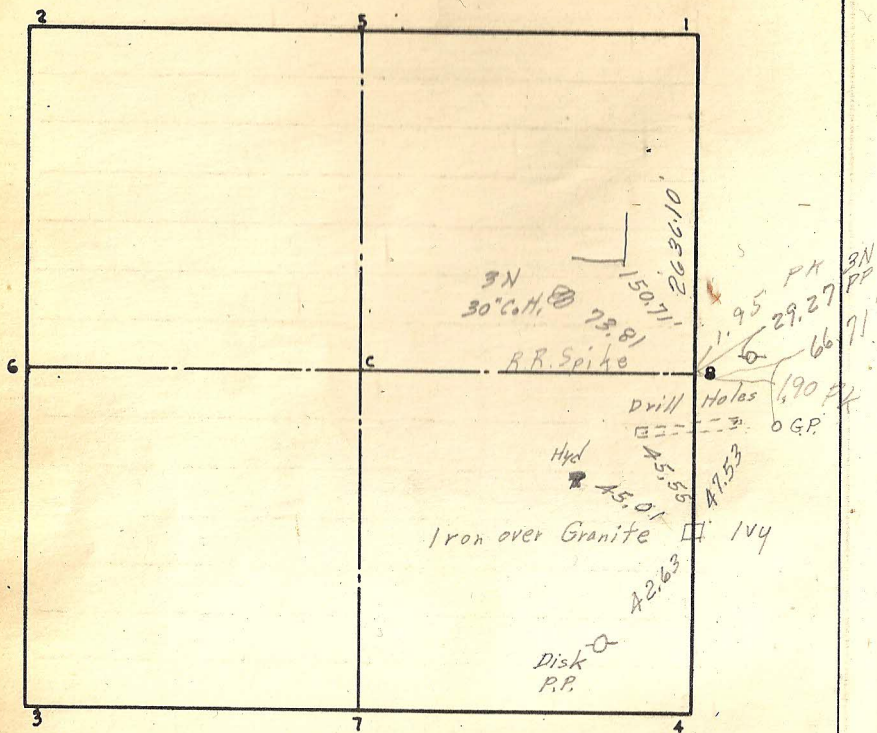

Cor. _____

Remarks _____

C. I.

1 _____

 2 _____

 3 _____

 4 _____

 5 _____

 6 _____

 7 _____

 8 $\frac{8}{108}$ _____

 C _____

