


SEC. 24 TWP. 29 RGE. 22

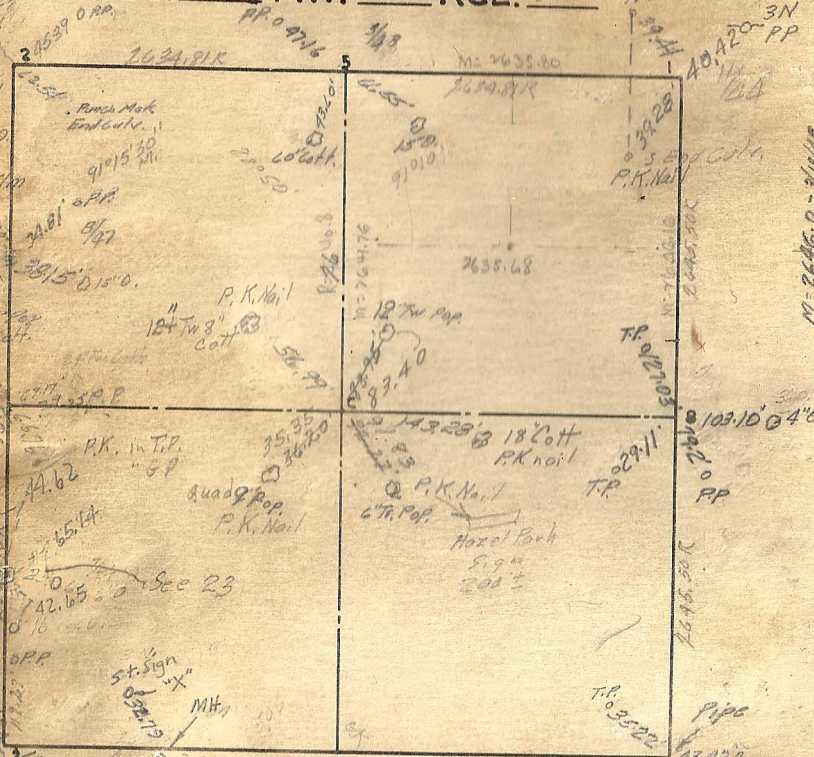

Cor: 26457.R
 26459.M 2/3
 1322.65 — 1322.65

Remarks

- 8
- 6 Read - 11-8-37

- Granite 1 Retired 5/11/1939 12/67
- 2
- Mont. 3 Found Norton Adm. stake - 3-23-48
6/60
- 4
- 5 RESET - 11/24/48 OK
- 6
- Granite 7 OK 12/67
- 8
- Granite c 11/67 9/71