SEC. 25 TWP. 29 RGE. 22

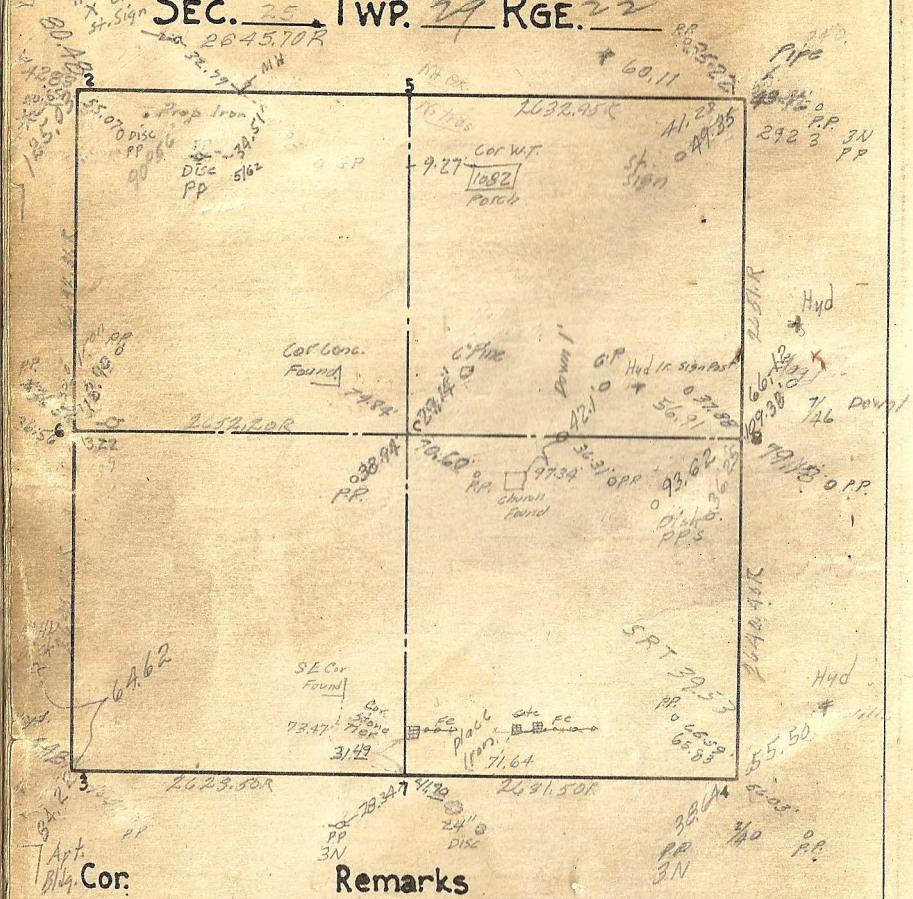

Cor.	Remarks
1	(Lowered) 10-20-33
2	OK 3/62
3	Granite 2/67
4	Iron Pin Over Granite 12/67
5	Granite OK 12/67
6	Reset From City of St. Paul TIES 18 MAY 1962
7	Iron Pin 12/66
8	Iron Pipe over Pin Over Granite 12/67
C	