


M.H.D. Disk
 64.62 SEC. 36 TWP. 29 RGE. 22 Hyd Hyd

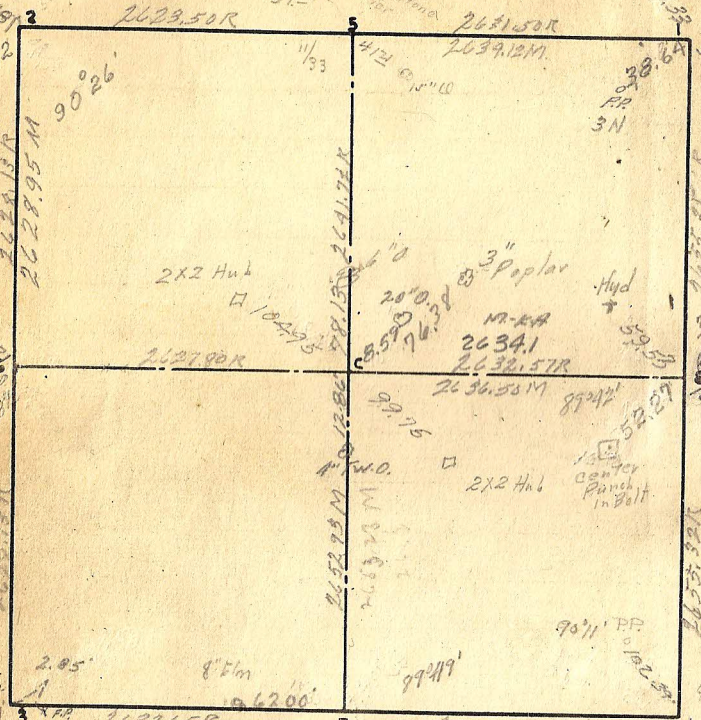

Cor.	Remarks
8	Replaced 1/25
	Frontage Rd.
	0.5 spike

- Iron Pin over Granite 1 12/17
- Granite 2 2/67
- 3
- 4
- Iron Pin 5 12/166
- 6
- Granite 7 10/40 (Note 77.15' so of South corner) 10/65
- Granite Down 0.55' 8 12/167
- C New Ties 6/36