1/4 Mi W of English

Tie 0.27 N of Line

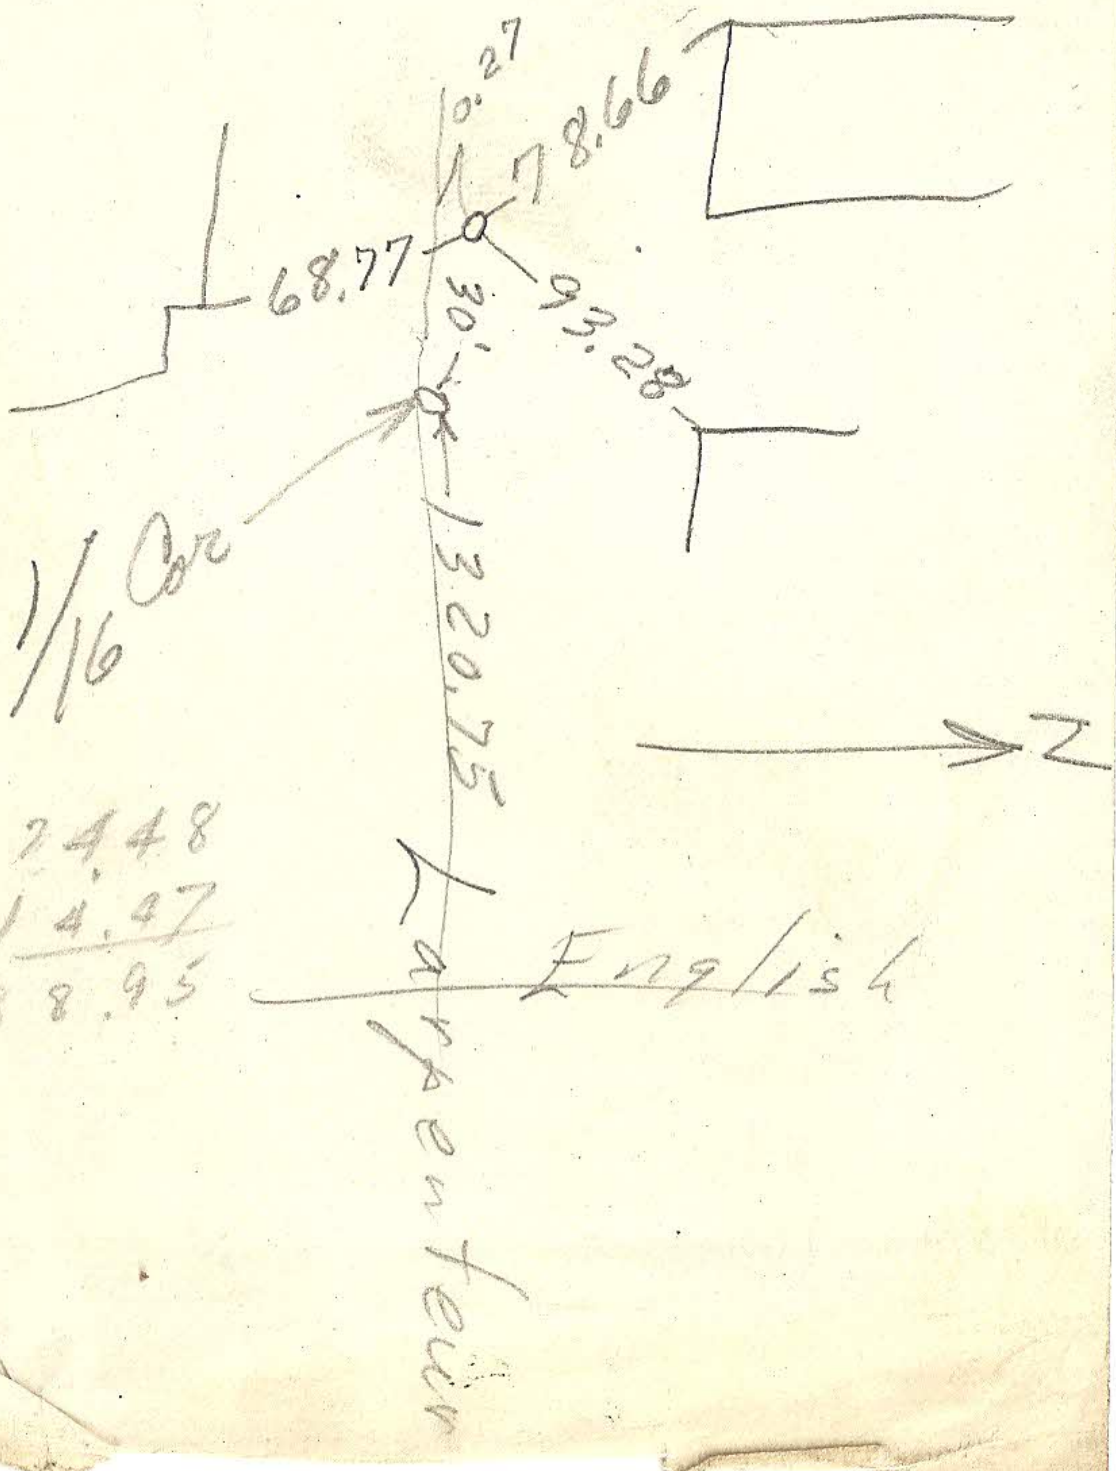

2448
14.97
88.95