SEC. 1 TWP. 29 RGE. 23

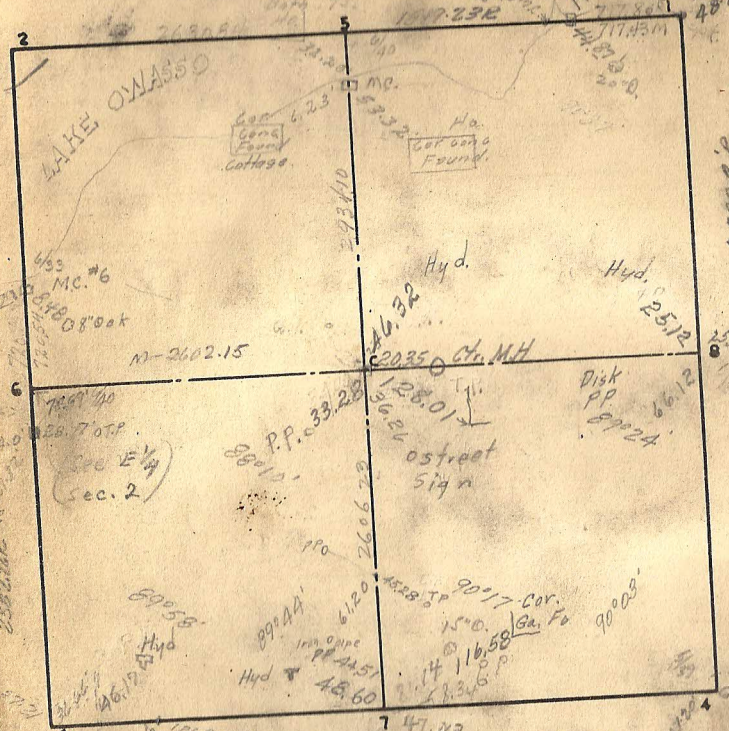
LAKE OWASSO
Cor. Found Cottage
Ha. Found
Hyd.
Hyd.
Hyd.
M.C. #6
N-2602.15
Ctr. MH
Disk PP
P.P.
Sec E¼ Cor Sec. 2
Street Sign
Iron & pipe
Cor.
Cor. Fd
T.P. Disk
2612'R
