SEC. 3 TWP. 29 RGE. 23

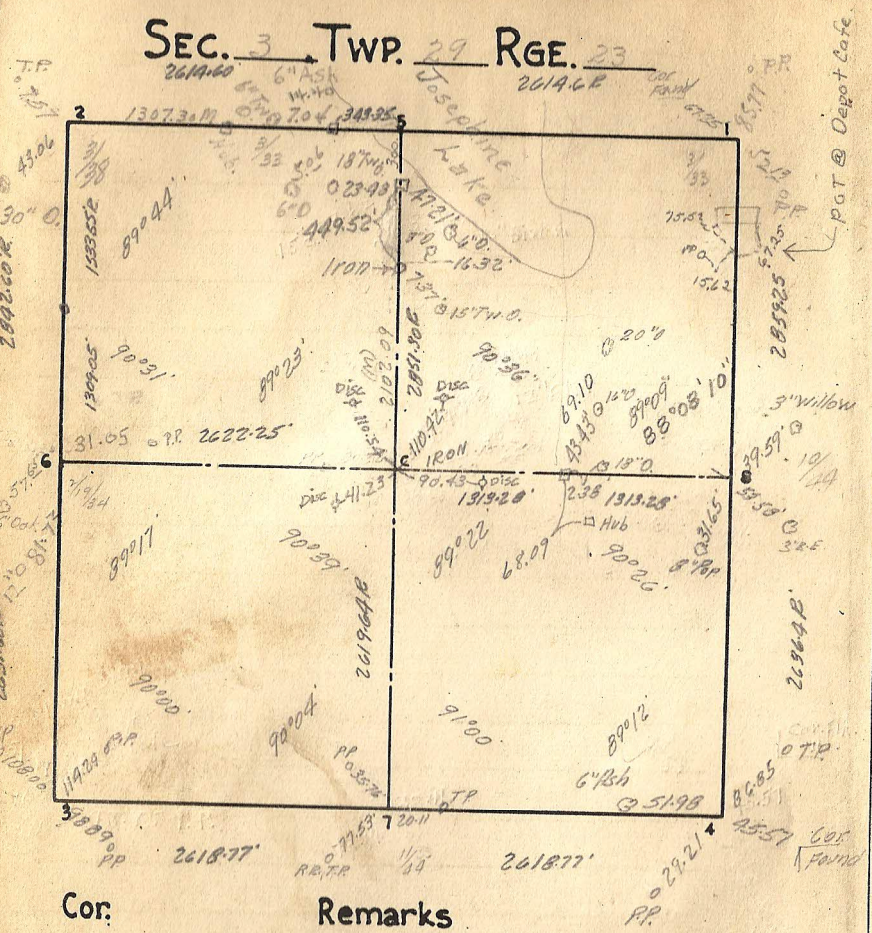

Cor. **Remarks**

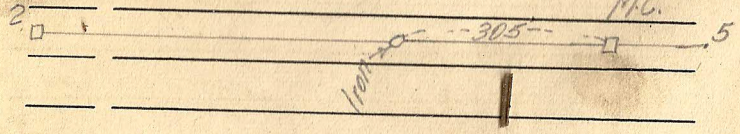

1 Found old Oak hub also Gov. W.T.
Set mont May 1896

2 Found old Stake no witness trees
Set mont May 1896

3 Fixed Jan 7-1897

4 Founed old iron Stake no witness
trees Set Mont May 1896

5

6 Found old stake & 2 witness trees
Set mont May 1896

7 Fixed from old notes of G.R. Johnson
fixed Jan 1898 Mont set May 1898

8 Fixed by Armstrong Dec 1896
Set Mont May 1897

C (By intersection)
Set Iron 2-1-63