SEC. 4 TWP. 29 RGE. 23

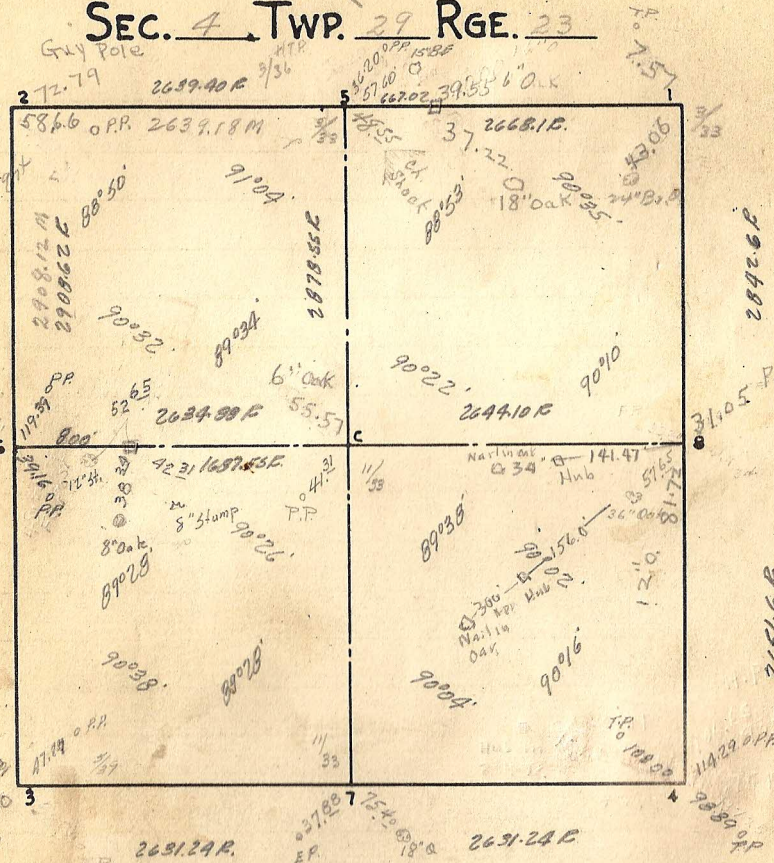

Cor.	Remarks
6	Est. Iron placed

1 Found old Stake Gov. W.T. gone
Set mont. May 1896

O/K 12/96 2 Fixed from line of old Fence
Set Mont. Aug. 1896

3 Found one Gov. W.T. standing fixed
and Set Mont Aug 1896

4 Prorated and fixed Jan 1897
Set Mont. Jan 1897

5

6 In Wilson Lake (original notes)

7 Ran Straight line cor. to cor. planed
mont halfway May 1897

8 Found old Stake at 1/4 Cor. & 2
old Gov. W.T. Reted & Set mont 5/1896

C By intersection May 1897