SEC. 5 TWP. 29 RGE. 23

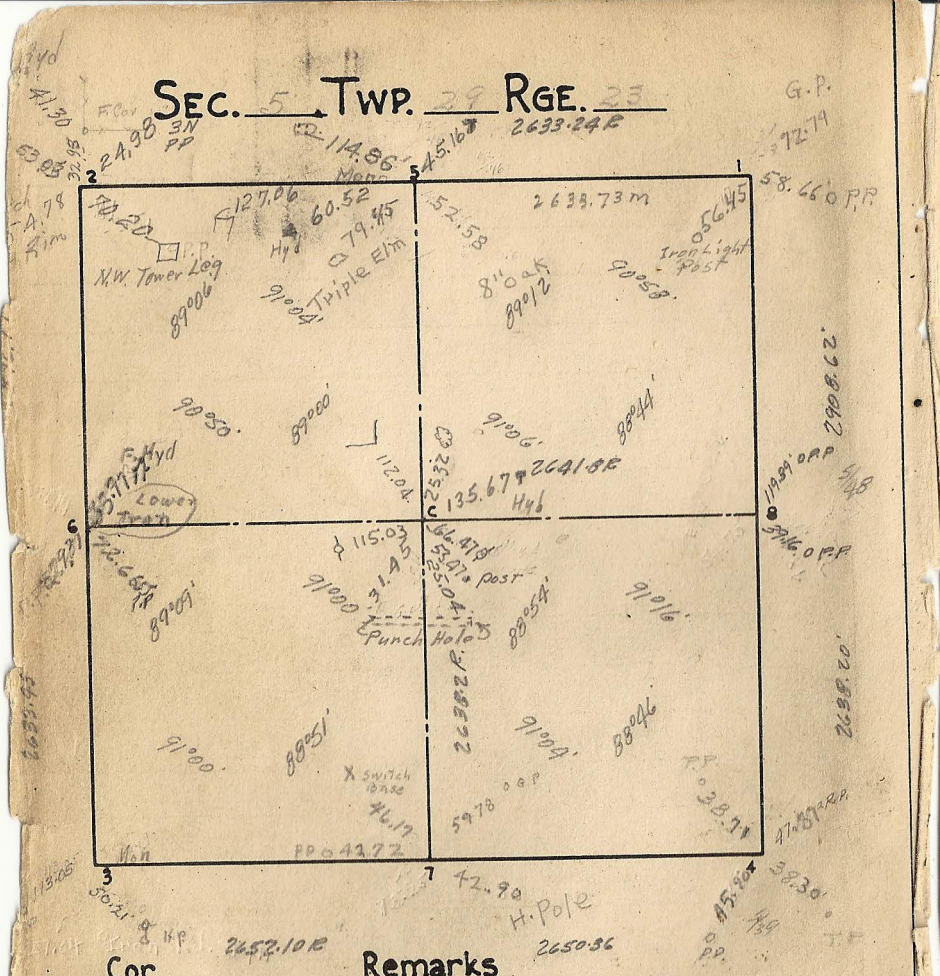

Cor.	Remarks
8	Est placed Mont
7	Tied in Mounds View Notes
3	" " " " "

OK 12/46 1 Fixed from line of old fence Set Mont Aug. 1896

Hennepin Co. C. I. 2 Found Mont. set by Hennepin Co Tied it out in June 1897

3 Found Mont Set by Hennepin Co. Tied it out Dec. 1899

4 Found old Gov. W.T. standing tied and Set Mont. Aug. 1896

Granite 8/65 OK 12/46 5 Found old Stake Gov. W.T's gone Tied June 1897 Set Mont Aug. 1897

6 Ran Staight line N. & S. from Cor. To Cor. Prorated & set Mont Apr. 1900

7 Found old Gov W.Ts Tied it out in Dec. 1899 Set Mont. Apr. 1900

8 In Wilson Lake Old Notes.

OK 12/46 C By intersection Set Mont Aug. 19