

SEC. 6 TWP. 29 RGE. 23

P.P.

Fc. Cor.

R.P. 52.98
27.02


Hyd. 48.18

44.41 97.80
97.68 P.P.

53.08

32.96

86.51 P.P.

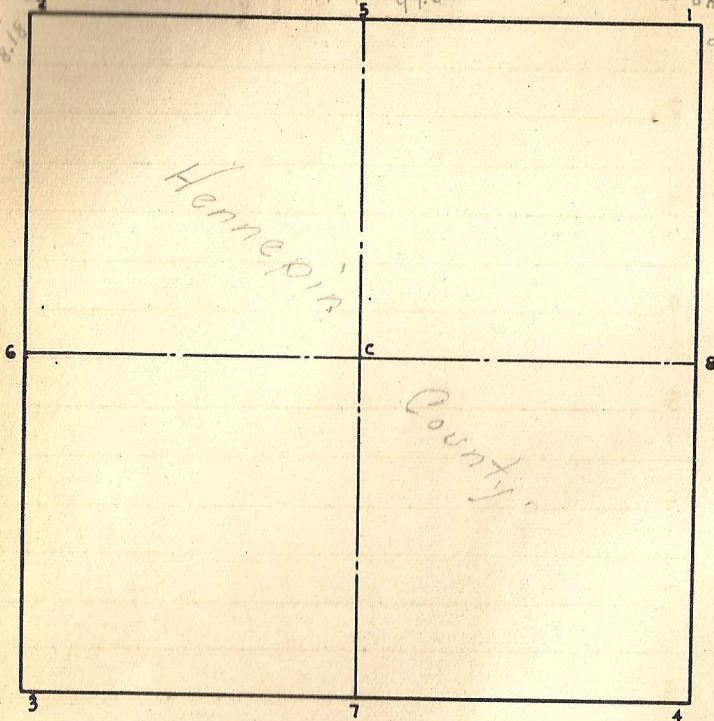

Cor: Remarks

1 _____

2 _____

3 _____

4 _____

5 _____

6 _____

7 _____

8 _____

C _____
