SEC. 7 TWP. 29 RGE. 23

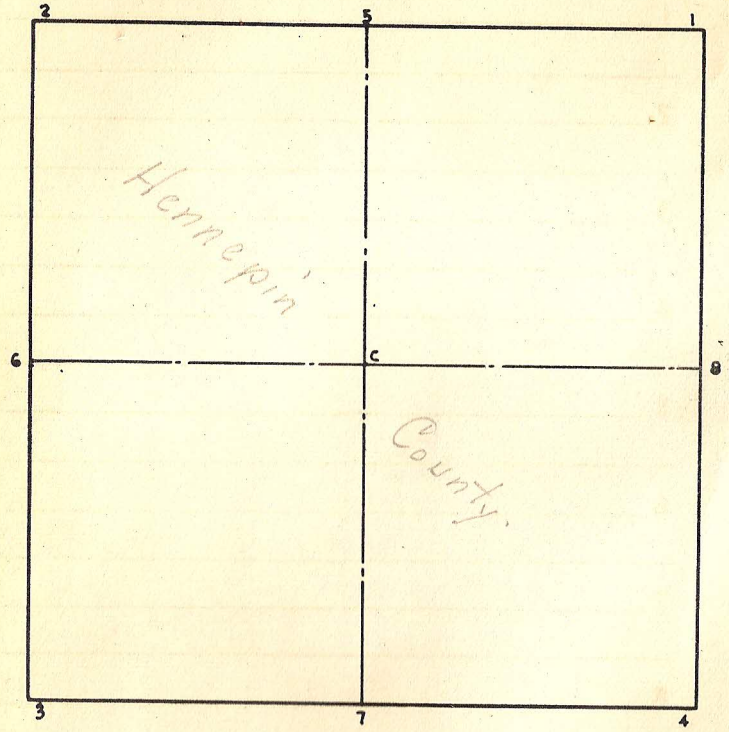

Cor. Remarks

1

2

3

4

5

6

7

8

C