


SEC. 8 TWP. 29 RGE. 23

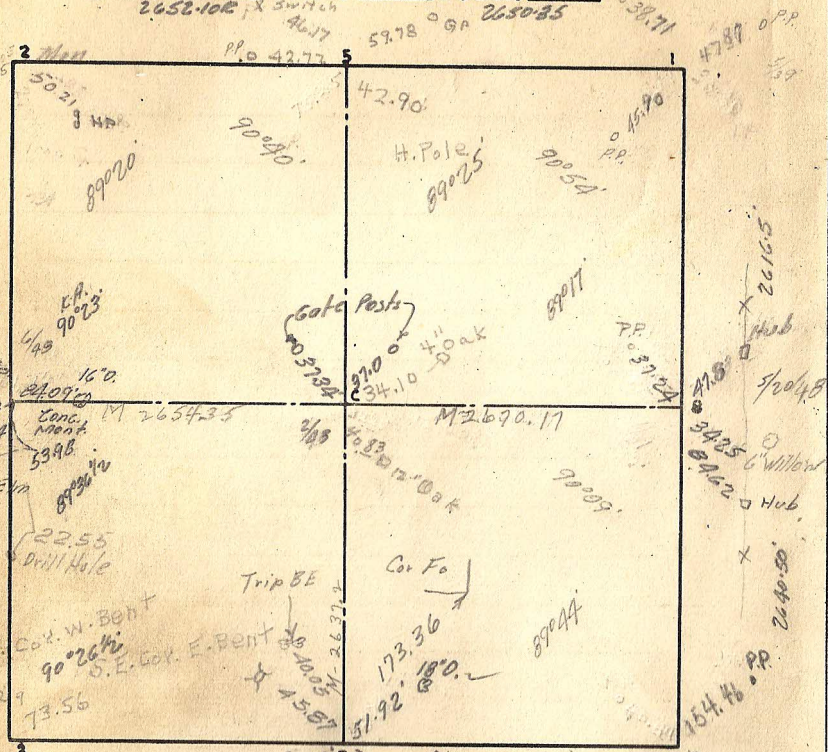

Cor: Remarks

- 7 Reset 5-21-33
- 7 Mont missing Reel road with 2 iron 10/12/33
- 6 Located 1/27/34 Don. Sandstone
- 4 Retied 5-9-63

- 1 Found one Coy. M.T. standing
Set Mont. Aug. 1896
- 2 Mont Set by Hennepin Co.
Found & tied Dec. 1899
- 3 Found iron stake at corner. M.T. gone
Set mont. Aug. 1899
- 4 Found old Stake at cor. Coy. M.T. gone
Set Mont Aug. 1899
- 5 Found one Coy. M.T. fixed and tied
Dec. 1899 Set mont. Apr. 1900
- 6 Found both Coy. M.T.s mont set by
Hennepin Co. Tied out Sept 1899
- 7 Found Coy. Stamp - fixed & tied
Dec. 1899 Set Mont. Aug. 1899
- 8 Established from line of old fence
running W. Coy. M.T. gone Set Mont. 1899
- C By intersection Set mont Apr. 1900
- C RESET 8/10/51 - MT.

7/59