SEC. 10 TWP. 29 RGE. 23

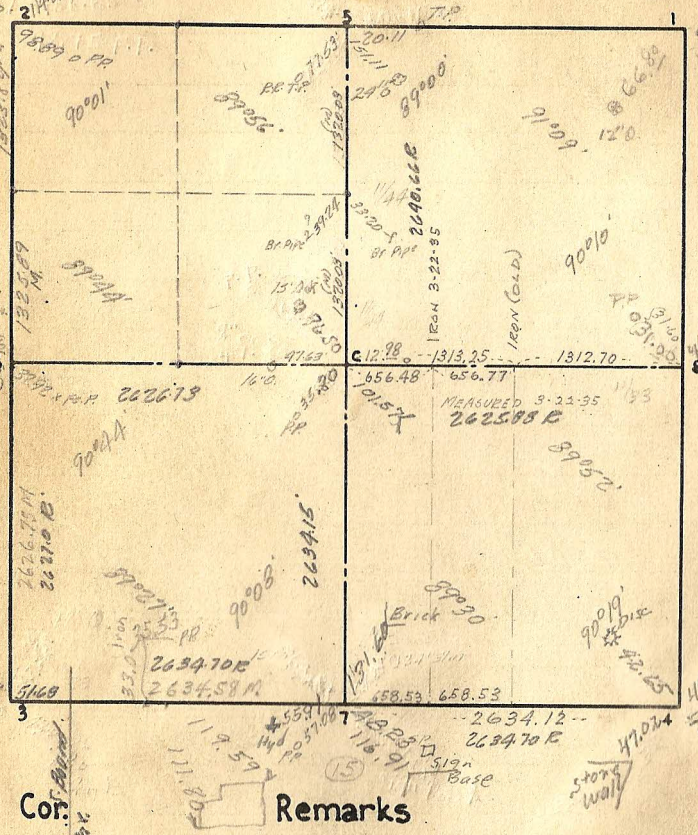

1 Found iron stake which had been in place 10 years. Set mont. May 1896

2 Fixed by pro. Jan. 1897 Gov. W.T. gone. Set mont 1898

3 Fixed from old fence line Mont. Set May. 1897

4 Found one Gov. W.T. also iron stake at cor. Set mont. June 1896

5 Lowered 2-52

6 Fixed from line of old fences RP S.W. 37.25 Set mont. May 1897

7

8

C NE=89°41', SE=90°19', SW=89°41', NW=90°19'