SEC. 11 TWP. 29 RGE. 23

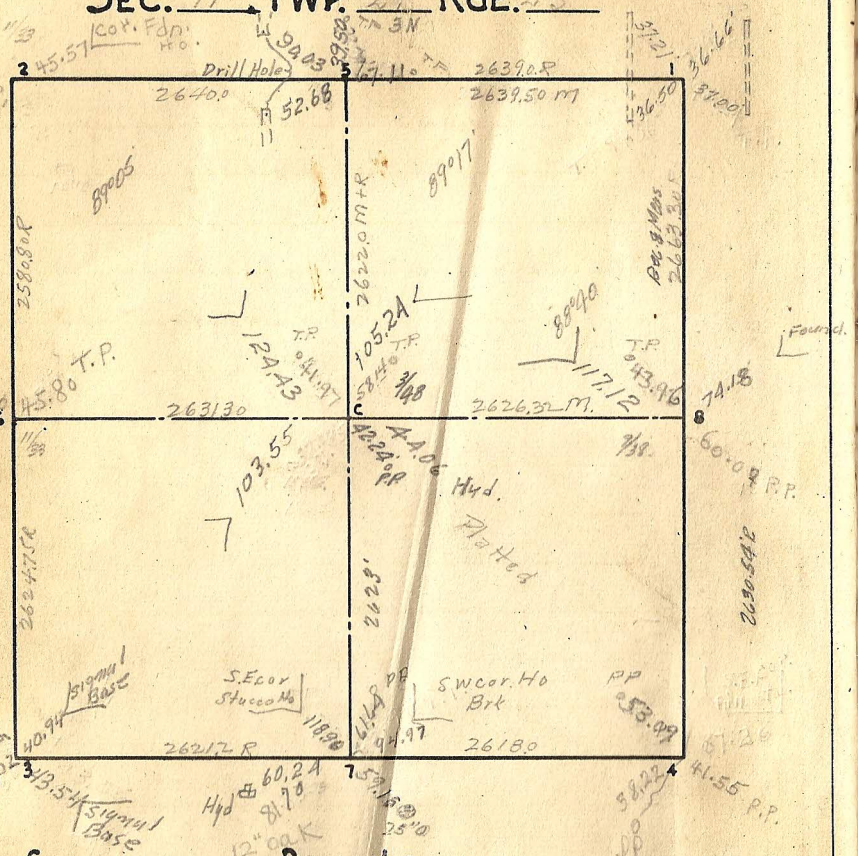

Cor.	Remarks

1 90°25'

2 89°05'

Granite 3 91°57' New Ties 3/59

4 88°33' (Retied 8-50) 3/54 3/59 3-13-61

C. I. 5 S.E. = 89°17', S.W. = 90°45' 3/66

6 N.E. = 91°48', S.E. = 88°10'

C. I. 7 N.W. = 88°15', N.E. = 91°38' 6/56 no mon. Ckd. 3-13-61 7/65

8 S.W. = 91°27', N.W. = 88°40' New Ties 3/59

C N.E. = 91°38', S.E. = 88°22', S.W. = 91°38', N.W. = 88°22'

Mont. New ties 3/59

N

.84 W .78

1.10

S