Punch mark on ends of cuts.

SEC. 12 TWP. 39 RGE. 23

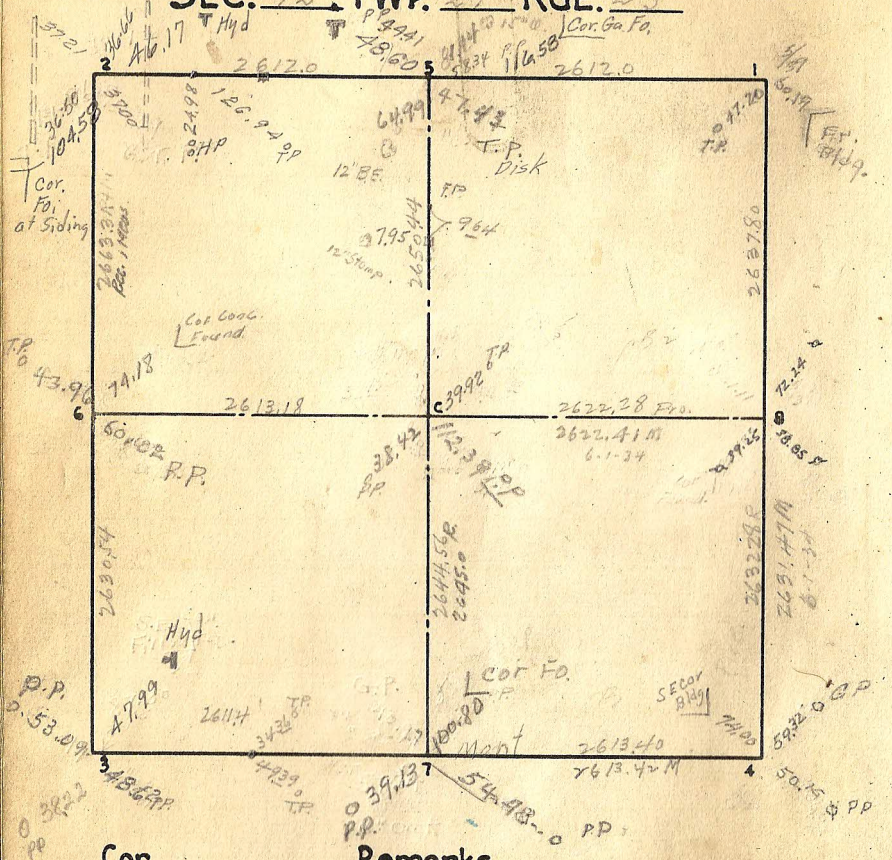
2612.0
2612.0
T.P. Disk
Cor. Found
2613.18
2622.28 Fnd.
2622.41 M
6-1-34
R.P.
Hyd
Cor. Fd.
Mont
2613.40
2613.42 M
SE Cor Bldg
Cor. Fd. at Siding
Fr. Bldg.
Cor. Ga. Fd.
