SEC. 13 TWP. 29 RGE. 23

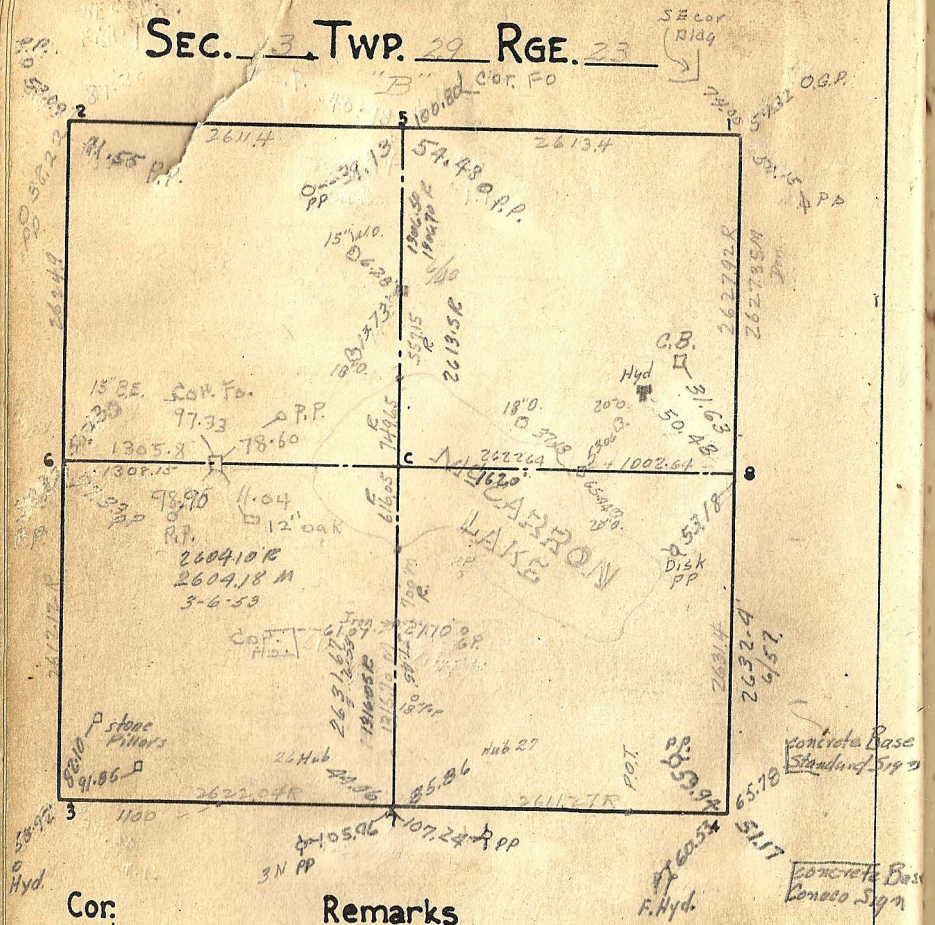

Cor.	Remarks
7	Reset - 2-15-3N Set iron 2-16-34
6	Reset - 9-8-34 POT

1 89°37' — 9-12-50

2 89°49' 3/5A 3-13-61

3 S.W. = 90°09½'

4 Reset 3-27-63 Mont Down 0.5'

S.E. = 90°37'

5 S.W. = 89°51'

Reset 3-13-61

6 3/5A

iron 7 3/5A OK 3/61

Brass Plug 8 2/68

C