SEC. 14 TWP. 29 RGE. 23

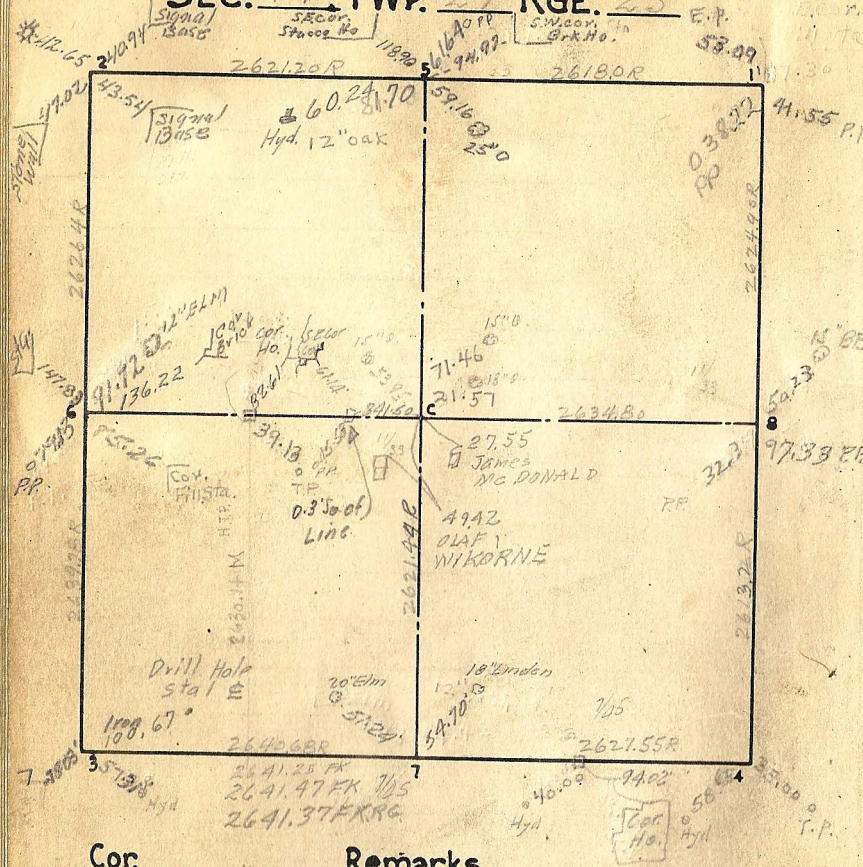


| Cor. | Remarks |
|---|---|
| 6 | Reset - 9-8-34 P.O.T. on Dale + 1 Tie |

1 91°29' 3/54 3-13-61

Granite 2 88°41'

3

4

C. I 5 SE = 88°54' SW = 91°13' 6/56 No Mon CHkd. 3-13-61 7/65

6

7

8 3/54

Spike in Granite C 11/65