Sec. 15 Twp. 29 Rge. 23

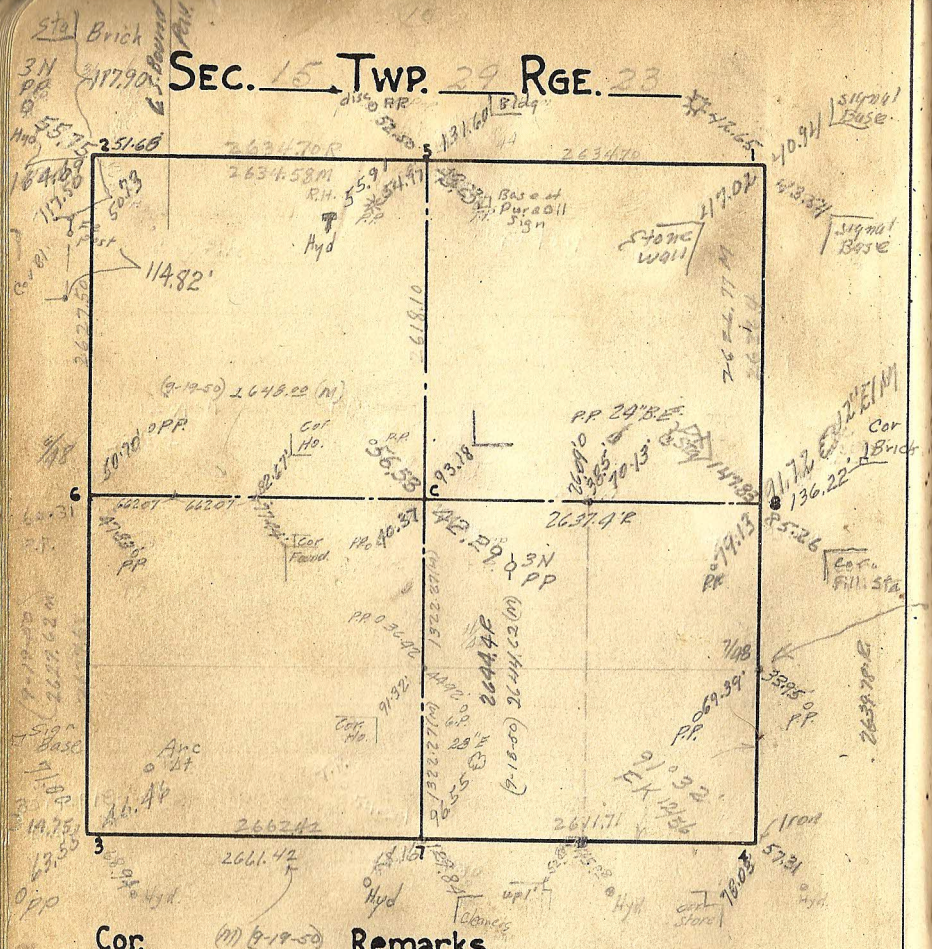

Cor. Remarks

66.207
66.207
13 24.14

1 89°01'

PK 1.42

Iron 2 90°58' 7/69

PK 1.18

3 New Ties 11/57

4

S.E. = 91°02'

5 S.W. = 89°20' New Ties 8/62

Found old C.R. Spk & R3 placed with Boot Spk. 7-1-48

6

7 NE = 89°02'

8

P.K. Nail C NEW TIES 3/1/63 KP 10/66