SEC. 16 TWP. 29 RGE. 33

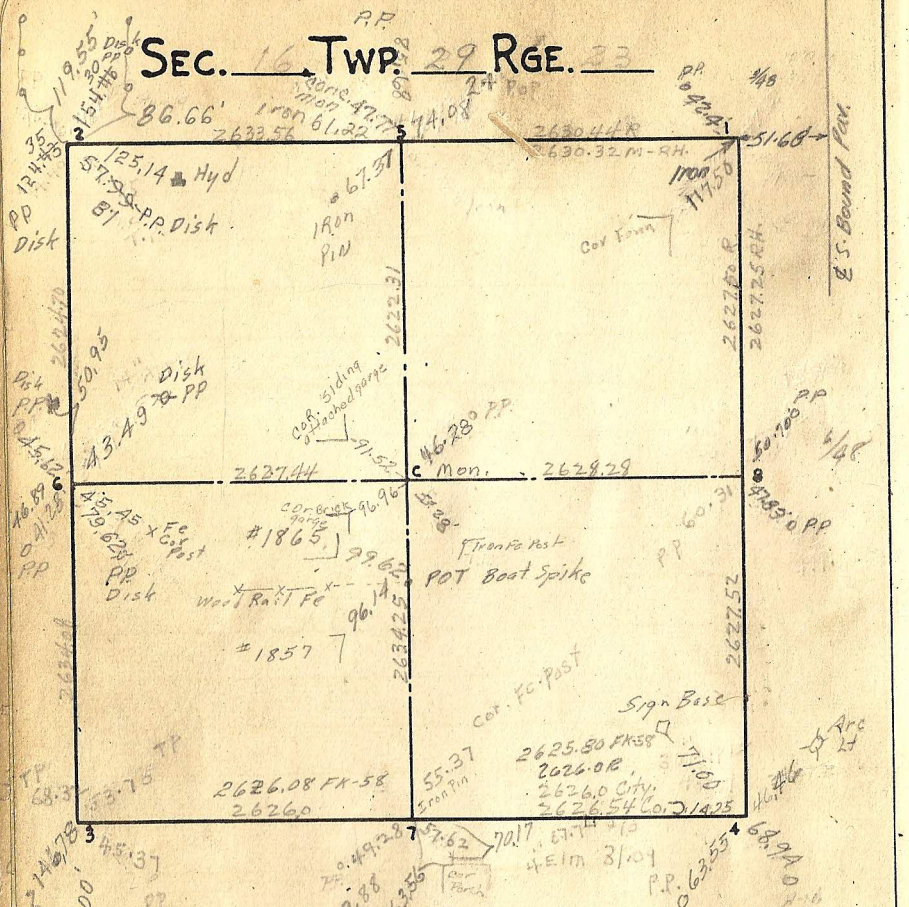

Cor.	Remarks
2	Retied 5/8/63

1 89°33'

2 90°06'

3

4 New Ties 11/57

Granite 1.40 PK 1.41 PK 5 S.E.=90°25 SW=89°34'

Retied 3-13-61

Granite 6 1/66

7

8

C Set Mont. to Road elev. Replacing iron 7-22-49

Retied 3-13-61