SEC. 17 TWP. 29 RGE. 23

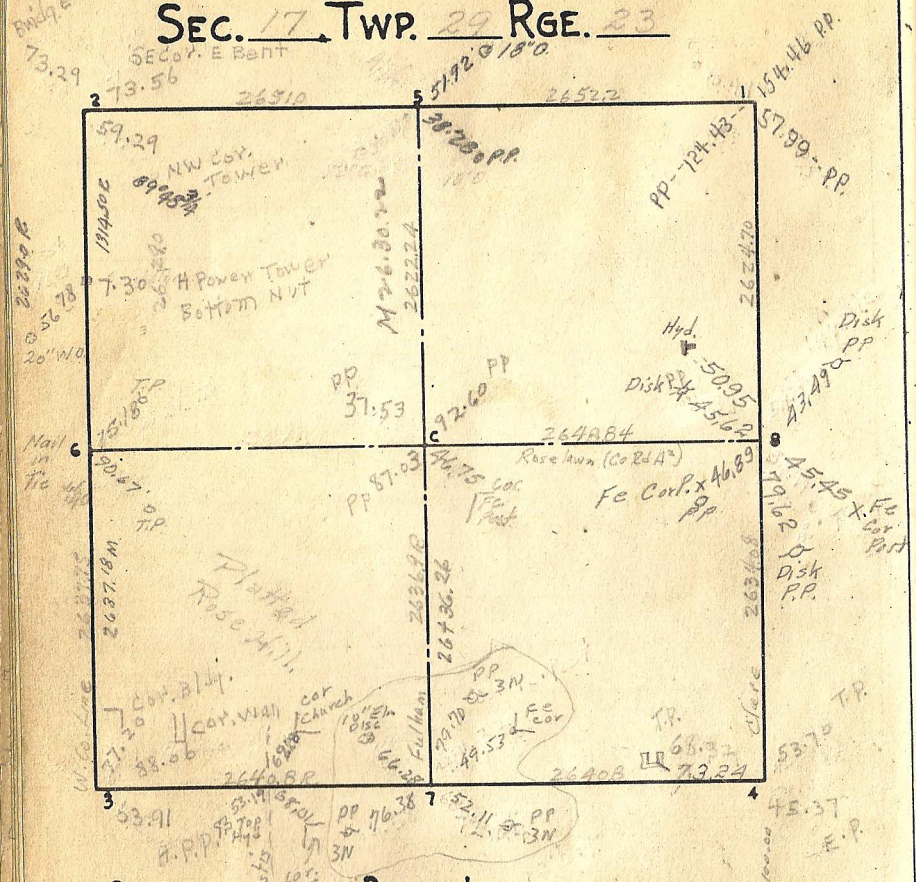

Cor.	Remarks
5	Reset 5-28-33
6	Est. 8/33 put nail in tie. (No ties)

1 90°06

2

3 2/2/59 4/6/61 R7G Tracks

4 Cor E. sta. Bend 76.82

5

6 Cor Bldg 43.25

7

Granite 8 1/66

C
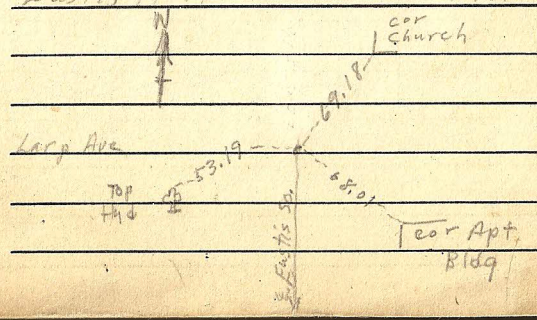
Eustis 1/4 1/4 Cor tied out 4/6/61 R7G